
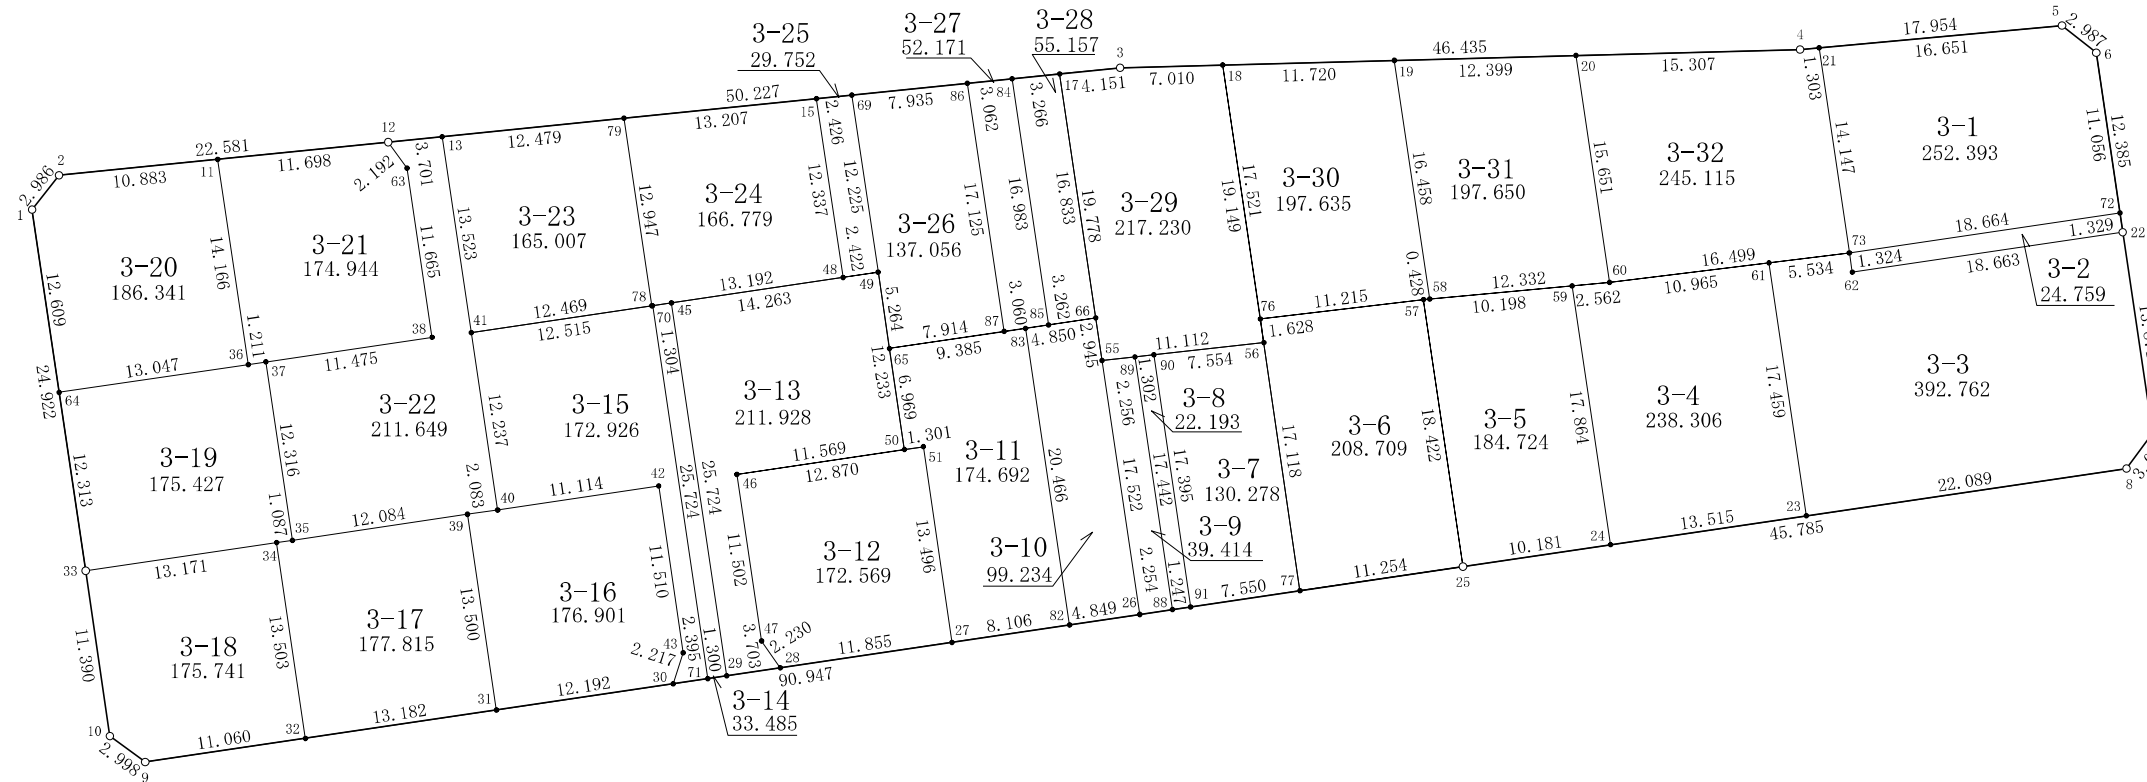


君津市 郡地区 画地出来形原子

郡一丁目3番

日付 平成21年12月18日

街区面積 5100.737
 合計面積 5100.742
 縮尺 1:500

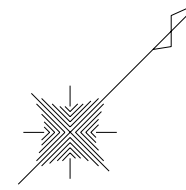

NO.	- X -	- Y -	NO.	- X -	- Y -	NO.	- X -	- Y -
6-1	-76676.241	7259.168	6-24	-76616.214	7351.540	6-46	-76654.992	7305.964
6-2	-76673.276	7258.815	6-25	-76624.387	7345.469	6-47	-76661.840	7315.205
6-3	-76616.865	7304.845	6-26	-76642.302	7332.181	6-48	-76640.359	7301.590
6-4	-76583.167	7336.793	6-27	-76652.707	7324.463	6-49	-76638.413	7303.032
6-5	-76569.363	7348.274	6-28	-76662.229	7317.401	6-50	-76645.701	7312.857
6-6	-76569.014	7351.241	6-29	-76665.203	7315.195	6-51	-76644.656	7313.632
6-7	-76584.658	7372.327	6-30	-76668.171	7312.994	6-52	-76631.869	7318.104
6-8	-76587.633	7372.771	6-31	-76677.963	7305.731	6-53	-76623.191	7325.044
6-9	-76697.434	7291.289	6-32	-76688.551	7297.878	6-54	-76613.409	7330.675
6-10	-76697.885	7288.325	6-33	-76691.077	7279.193	6-55	-76613.080	7330.948
6-11	-76664.849	7265.702	6-34	-76680.498	7287.039	6-56	-76605.568	7337.195
6-12	-76655.792	7273.105	6-35	-76679.633	7287.698	6-57	-76603.598	7338.833
6-13	-76652.924	7275.444	6-36	-76673.279	7277.087	6-58	-76594.956	7345.582
6-14	-76633.016	7291.676	6-37	-76672.302	7277.802	6-59	-76591.383	7350.051
6-15	-76620.082	7302.222	6-38	-76663.086	7284.638	6-60	-76656.136	7275.270
6-16	-76611.778	7309.668	6-39	-76669.921	7294.888	6-61	-76683.747	7269.299
6-17	-76603.273	7317.731	6-40	-76668.258	7296.143	6-62	-76641.549	7307.260
6-18	-76594.275	7326.262	6-41	-76660.974	7286.310	6-63	-76630.114	7315.739
6-19	-76582.165	7337.626	6-42	-76659.324	7302.754	6-64	-76631.136	7293.209
6-20	-76576.402	7361.181	6-43	-76666.195	7311.988	6-65	-76650.919	7293.762
6-21	-76605.365	7359.599	6-44	-76649.872	7294.539	6-66	-76666.247	7314.421
6-22						6-67		
6-23						6-68		
						6-69		
						6-70		
						6-71		
						6-72	-76575.609	7360.114
						6-73	-76590.594	7348.988
						6-74	-76622.221	7323.737
						6-75	-76633.426	7338.765
						6-76	-76650.957	7293.735
						6-77	-76643.252	7283.330
						6-78	-76646.196	7329.292
						6-79	-76634.010	7312.850
						6-80	-76622.613	7300.158
						6-81	-76632.734	7313.796
						6-82	-76624.986	7298.223
						6-83	-76635.192	7311.974
						6-84	-76640.492	7333.525
						6-85	-76630.106	7319.512
						6-86	-76629.090	7320.326
						6-87	-76639.491	7334.269

現地とは必ずしも一致しないことがあります。あくまで参考図としてご利用ください。
 資料（写し）によって発生した直接または間接の損失、損害等について市では一切の責任を負いません。

大和測量株式会社