


君津市 郡地区 画地出来形原子

郡一丁目4番

日付 平成21年12月18日

NO.	- X -	- Y -
5-1	-76703.995	7296.551
5-2	-76701.030	7296.118
5-3	-76591.216	7377.603
5-4	-76590.773	7380.564
5-5	-76612.078	7409.275
5-6	-76615.038	7409.718
5-7	-76724.859	7328.221
5-8	-76725.289	7325.253
5-9	-76601.650	7395.222
5-10	-76609.327	7405.568
5-11	-76624.375	7402.777
5-12	-76645.492	7387.099
5-13	-76688.359	7305.531
5-14	-76677.100	7313.887
5-15	-76674.938	7315.491
5-16	-76672.774	7317.097
5-17	-76661.517	7325.451
5-18	-76650.269	7333.798
5-19	-76648.101	7335.406
5-20	-76645.937	7337.012
5-21	-76634.688	7345.360
5-22	-76611.784	7362.357
5-23	-76601.208	7370.197
5-24	-76602.812	7395.007
5-25	-76621.889	7403.238
5-26	-76630.945	7397.893
5-27	-76639.647	7391.436
5-29	-76651.157	7382.895
5-30	-76658.491	7377.454
5-31	-76669.746	7369.102
5-32	-76680.992	7360.758
5-33	-76692.239	7352.413
5-34	-76703.490	7344.064
5-35	-76714.738	7335.718

街区面積 5625.126
 合計面積 5625.079
 縮尺 1 : 500

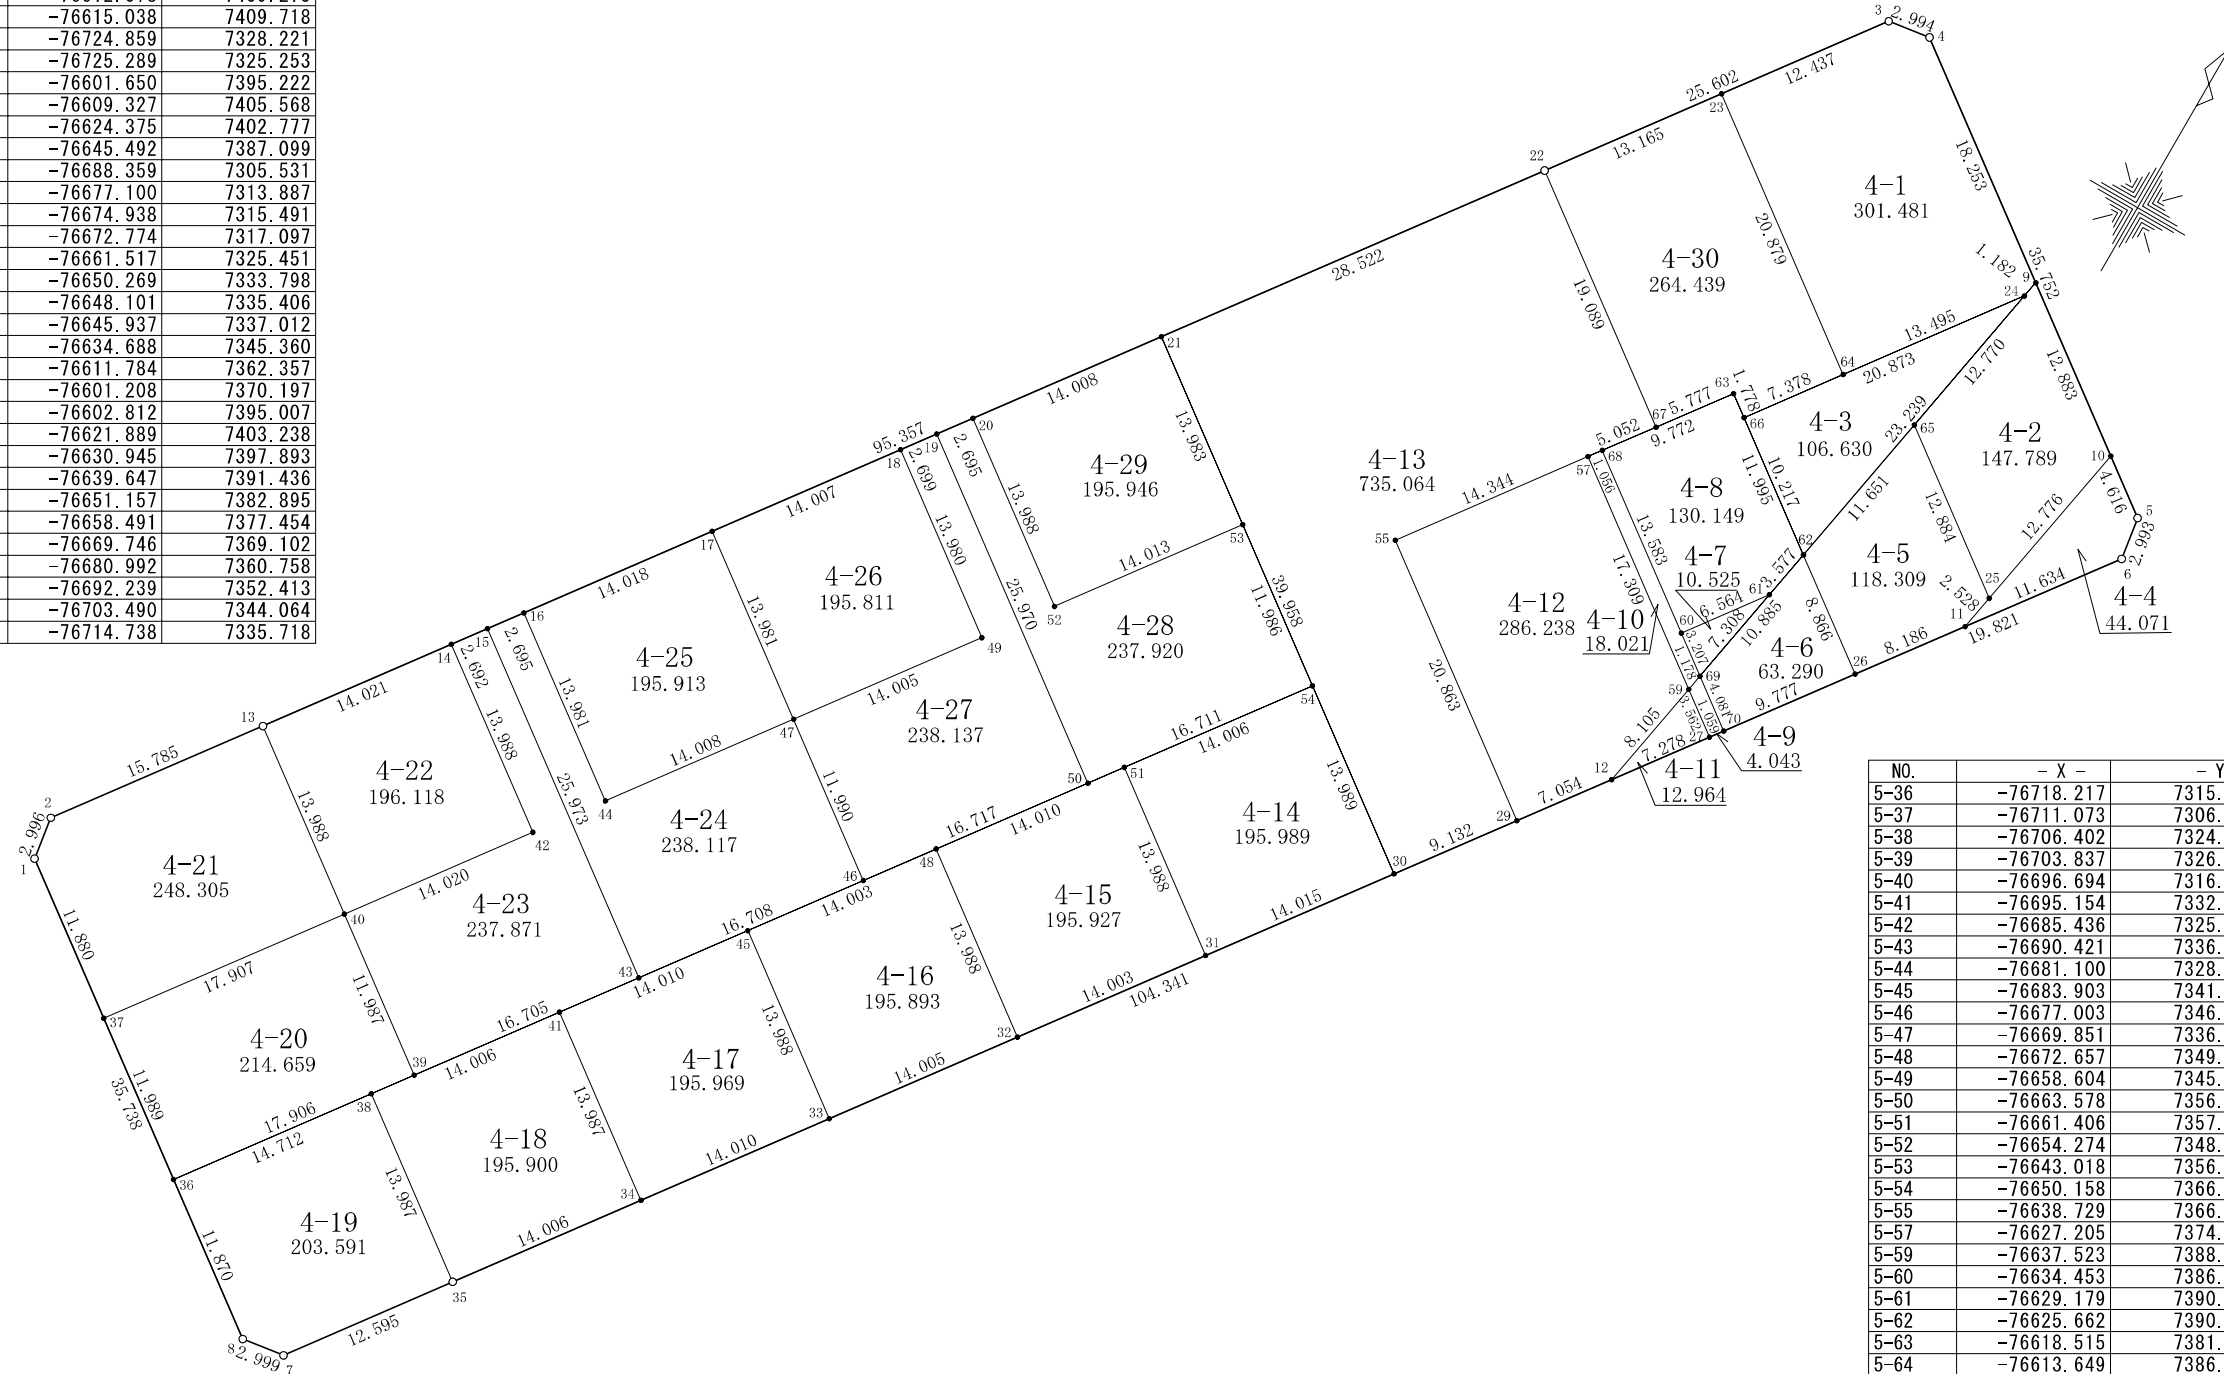

NO.	- X -	- Y -
5-36	-76718.217	7315.720
5-37	-76711.073	7306.092
5-38	-76706.402	7324.487
5-39	-76703.837	7326.390
5-40	-76696.694	7316.764
5-41	-76695.154	7332.832
5-42	-76685.436	7325.120
5-43	-76690.421	7336.344
5-44	-76681.100	7328.329
5-45	-76683.903	7341.180
5-46	-76677.003	7346.299
5-47	-76669.851	7336.676
5-48	-76672.657	7349.524
5-49	-76658.604	7345.022
5-50	-76663.578	7356.260
5-51	-76661.406	7357.872
5-52	-76654.274	7348.244
5-53	-76643.018	7356.591
5-54	-76650.158	7366.218
5-55	-76638.729	7366.138
5-57	-76627.205	7374.679
5-59	-76637.523	7388.576
5-60	-76634.453	7386.215
5-61	-76629.179	7390.122
5-62	-76625.662	7390.773
5-63	-76618.515	7381.140
5-64	-76613.649	7386.965
5-65	-76614.206	7392.896
5-66	-76619.574	7382.568
5-67	-76623.151	7377.693
5-68	-76626.357	7375.309
5-69	-76636.365	7388.790
5-70	-76638.797	7392.067

現地とは必ずしも一致しないことがあります。あくまで参考図としてご利用ください。
 資料（写し）によって発生した直接または間接の損失、損害等について市では一切の責任を負いません。

大和測量株式会社