



君津市 郡地区 画地出来形原子

郡一丁目6番

日付 平成21年12月18日

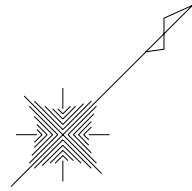

街区面積 5700.042
 合計面積 5700.004
 縮尺 1 : 500

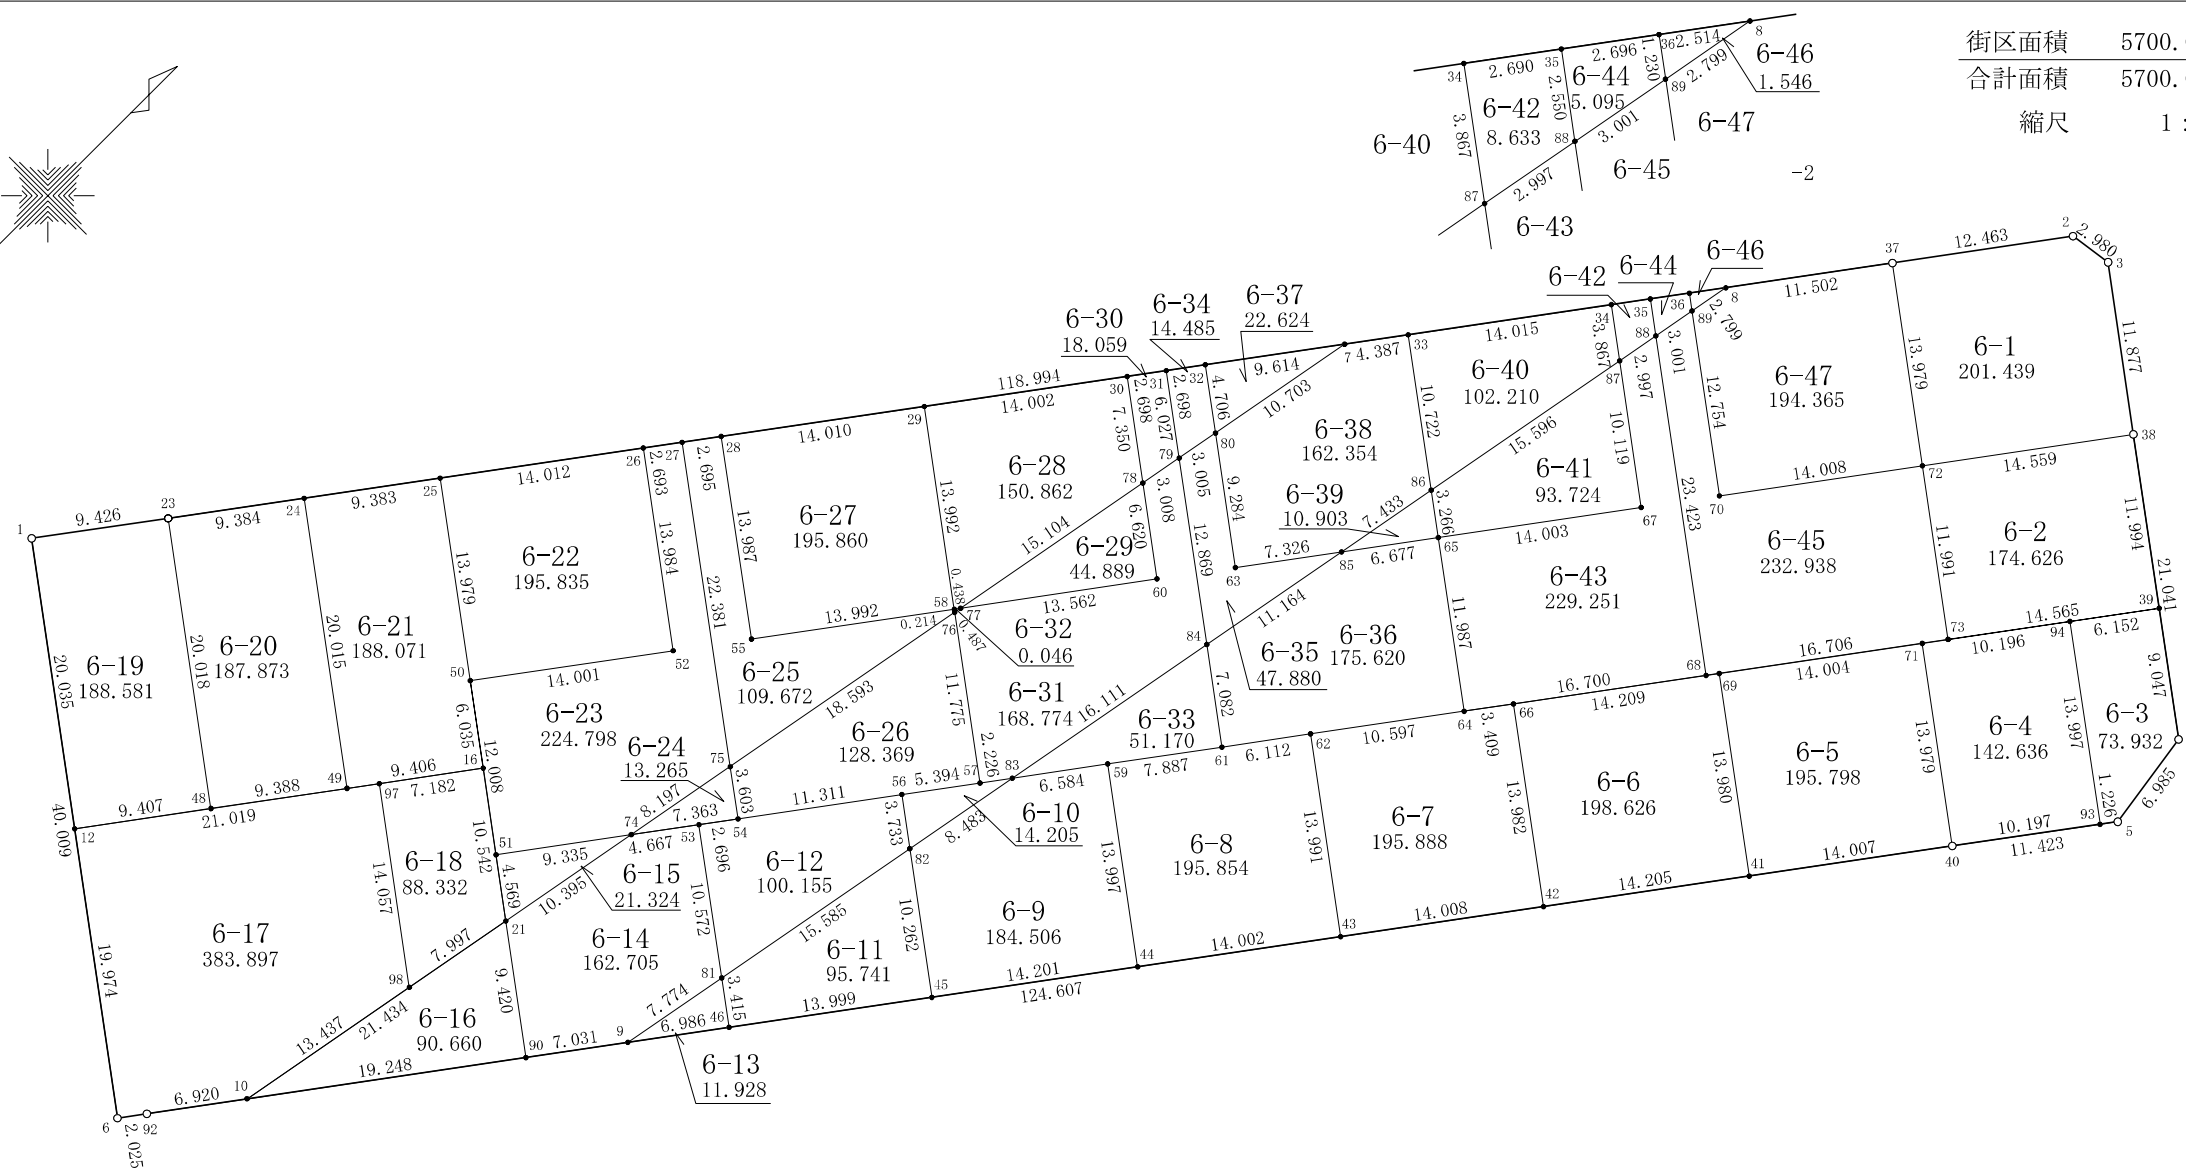

NO.	- X -	- Y -
8-1	-76731.739	7330.583
8-2	-76618.609	7414.546
8-3	-76618.178	7417.495
8-4	-76637.797	7443.927
8-5	-76644.704	7444.969
8-6	-76755.578	7362.714
8-7	-76658.983	7384.600
8-8	-76637.862	7400.275
8-9	-76727.282	7383.690
8-10	-76748.388	7368.034
8-12	-76743.677	7346.673
8-16	-76721.028	7363.475
8-21	-76727.313	7371.939
8-23	-76724.179	7336.213
8-24	-76716.644	7341.806
8-25	-76709.109	7347.397
8-26	-76697.857	7355.748
8-27	-76695.695	7357.353
8-28	-76693.531	7358.959

NO.	- X -	- Y -
8-29	-76682.281	7367.309
8-30	-76671.037	7375.654
8-31	-76668.870	7377.262
8-32	-76666.703	7378.870
8-33	-76655.460	7387.215
8-34	-76644.206	7395.567
8-35	-76642.046	7397.170
8-36	-76639.881	7398.777
8-37	-76628.626	7407.130
8-38	-76625.264	7427.026
8-39	-76632.408	7436.660
8-40	-76653.866	7438.147
8-41	-76665.116	7429.802
8-42	-76676.525	7421.339
8-43	-76687.776	7412.994
8-44	-76699.022	7404.652
8-45	-76710.428	7396.192
8-46	-76721.671	7387.852
8-48	-76736.122	7352.278

NO.	- X -	- Y -
8-49	-76728.582	7357.871
8-50	-76717.430	7358.630
8-51	-76724.589	7368.271
8-52	-76706.190	7366.978
8-53	-76713.344	7376.614
8-54	-76711.179	7378.220
8-55	-76701.855	7370.199
8-56	-76702.090	7384.952
8-57	-76697.763	7388.173
8-58	-76690.623	7378.542
8-59	-76690.680	7393.413
8-60	-76679.368	7386.868
8-61	-76684.353	7398.122
8-62	-76679.440	7401.758
8-63	-76675.039	7390.106
8-64	-76670.934	7408.078
8-65	-76663.793	7398.450
8-66	-76668.196	7410.109
8-67	-76652.547	7406.793

NO.	- X -	- Y -
8-68	-76657.522	7418.028
8-69	-76656.785	7418.575
8-70	-76648.210	7410.010
8-71	-76645.538	7426.919
8-72	-76636.958	7418.354
8-73	-76644.105	7427.982
8-74	-76717.092	7373.833
8-75	-76709.032	7375.326
8-76	-76690.750	7378.714
8-77	-76690.271	7378.803
8-78	-76675.420	7381.554
8-79	-76672.462	7382.102
8-80	-76669.507	7382.650
8-81	-76719.638	7385.108
8-82	-76704.314	7387.950
8-83	-76695.973	7389.497
8-84	-76680.132	7392.435
8-85	-76669.155	7394.471
8-86	-76661.847	7395.827

NO.	- X -	- Y -
8-87	-76646.512	7398.671
8-88	-76643.565	7399.218
8-89	-76640.614	7399.765
8-90	-76732.929	7379.502
8-92	-76753.946	7363.912
8-93	-76645.687	7444.237
8-94	-76637.349	7432.994
8-95	-76721.734	7362.951
8-96	-76728.276	7371.761
8-97	-76726.796	7359.196
8-98	-76735.176	7370.482

現地とは必ずしも一致しないことがあります。あくまで参考図としてご利用ください。
 資料（写し）によって発生した直接または間接の損失、損害等について市では一切の責任を負いません。

大和測量株式会社