
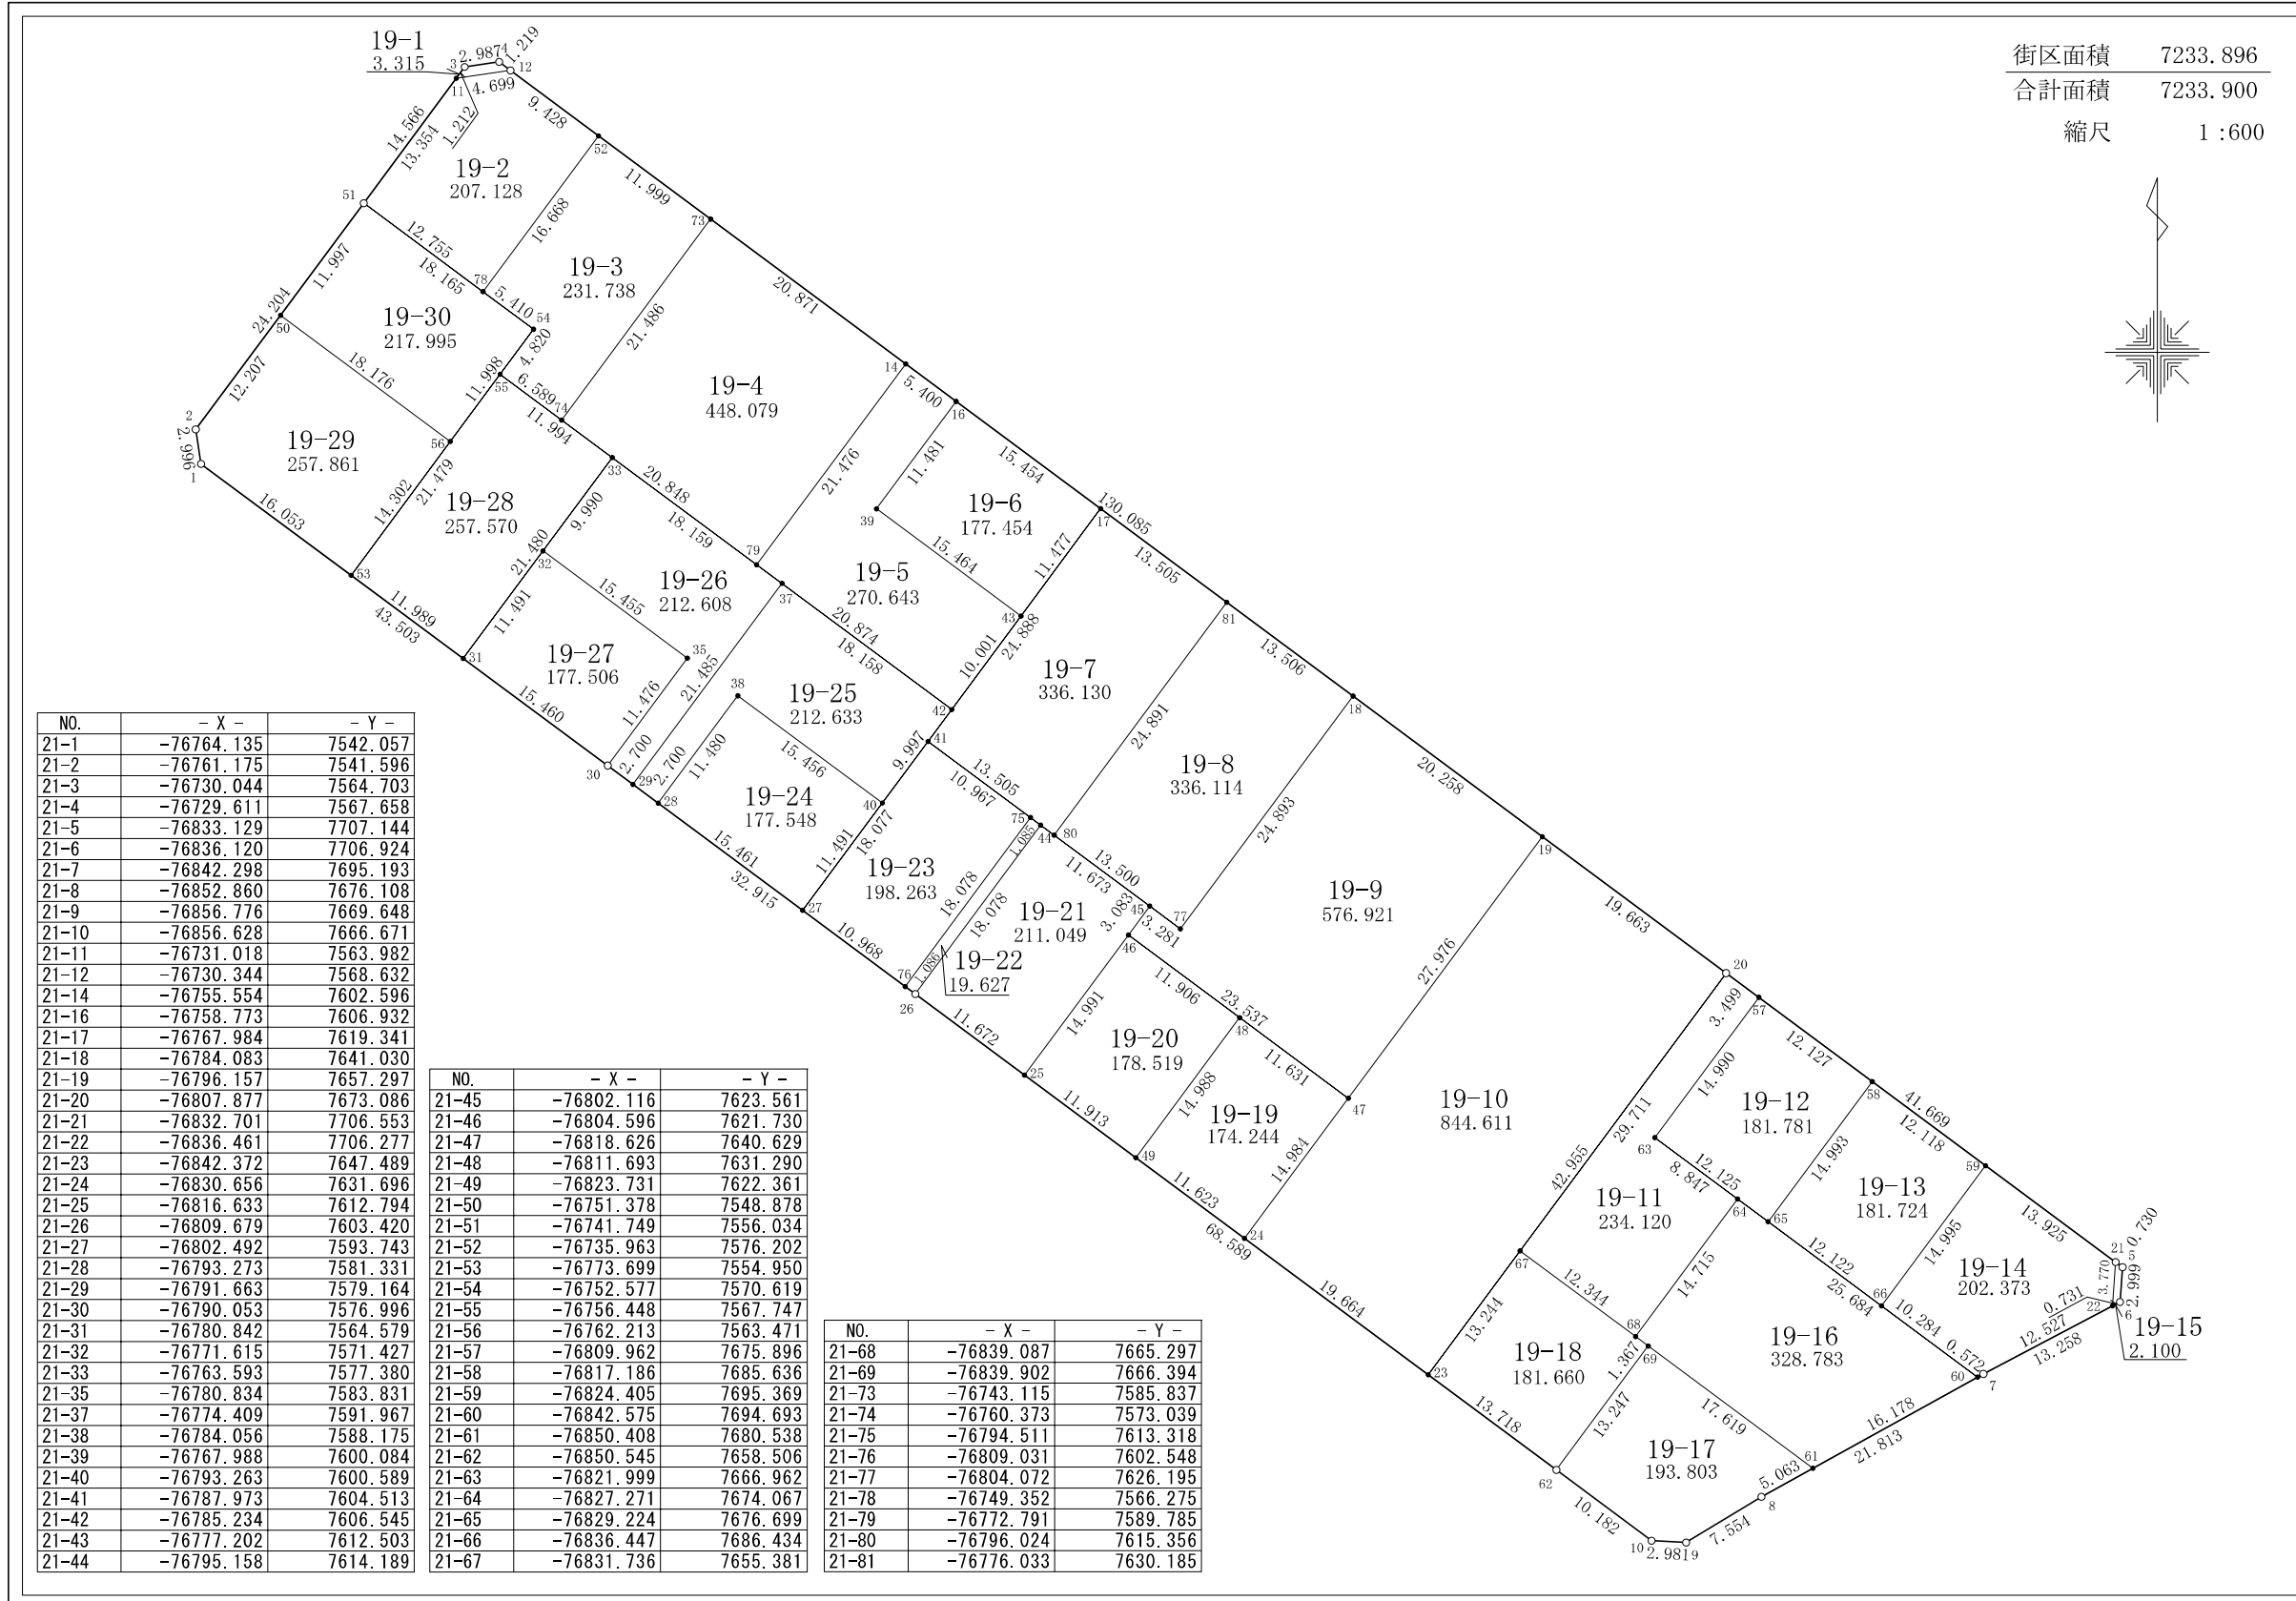


君津市 郡地区 画地出来形原子

郡一丁目19番

日付 平成21年12月18日

街区面積 7233.896  
 合計面積 7233.900  
 縮尺 1:600

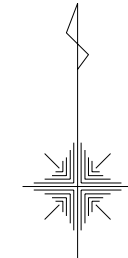

NO.	- X -	- Y -
21-1	-76764.135	7542.057
21-2	-76761.175	7541.596
21-3	-76730.044	7564.703
21-4	-76729.611	7567.658
21-5	-76833.129	7707.144
21-6	-76836.120	7706.924
21-7	-76842.298	7695.193
21-8	-76852.860	7676.108
21-9	-76856.776	7669.648
21-10	-76856.628	7666.671
21-11	-76731.018	7563.982
21-12	-76730.344	7568.632
21-14	-76755.554	7602.596
21-16	-76758.773	7606.932
21-17	-76767.984	7619.341
21-18	-76784.083	7641.030
21-19	-76796.157	7657.297
21-20	-76807.877	7673.086
21-21	-76832.701	7706.553
21-22	-76836.461	7706.277
21-23	-76842.372	7647.489
21-24	-76830.656	7631.696
21-25	-76816.633	7612.794
21-26	-76809.679	7603.420
21-27	-76802.492	7593.743
21-28	-76793.273	7581.331
21-29	-76791.663	7579.164
21-30	-76790.053	7576.996
21-31	-76780.842	7564.579
21-32	-76771.615	7571.427
21-33	-76763.593	7577.380
21-35	-76780.834	7583.831
21-37	-76774.409	7591.967
21-38	-76784.056	7588.175
21-39	-76767.988	7600.084
21-40	-76793.263	7600.589
21-41	-76787.973	7604.513
21-42	-76785.234	7606.545
21-43	-76777.202	7612.503
21-44	-76795.158	7614.189

NO.	- X -	- Y -
21-45	-76802.116	7623.561
21-46	-76804.596	7621.730
21-47	-76818.626	7640.629
21-48	-76811.693	7631.290
21-49	-76823.731	7622.361
21-50	-76751.378	7548.878
21-51	-76741.749	7556.034
21-52	-76735.963	7576.202
21-53	-76773.699	7554.950
21-54	-76752.577	7570.619
21-55	-76756.448	7567.747
21-56	-76762.213	7563.471
21-57	-76809.962	7675.896
21-58	-76817.186	7685.636
21-59	-76824.405	7695.369
21-60	-76842.575	7694.693
21-61	-76850.408	7680.538
21-62	-76850.545	7658.506
21-63	-76821.999	7666.962
21-64	-76827.271	7674.067
21-65	-76829.224	7676.699
21-66	-76836.447	7686.434
21-67	-76831.736	7655.381

NO.	- X -	- Y -
21-68	-76839.087	7665.297
21-69	-76839.902	7666.394
21-73	-76743.115	7585.837
21-74	-76760.373	7573.039
21-75	-76794.511	7613.318
21-76	-76809.031	7602.548
21-77	-76804.072	7626.195
21-78	-76749.352	7566.275
21-79	-76772.791	7589.785
21-80	-76796.024	7615.356
21-81	-76776.033	7630.185

現地とは必ずしも一致しないことがあります。あくまで参考図としてご利用ください。  
 資料（写し）によって発生した直接または間接の損失、損害等について市では一切の責任を負いません。