
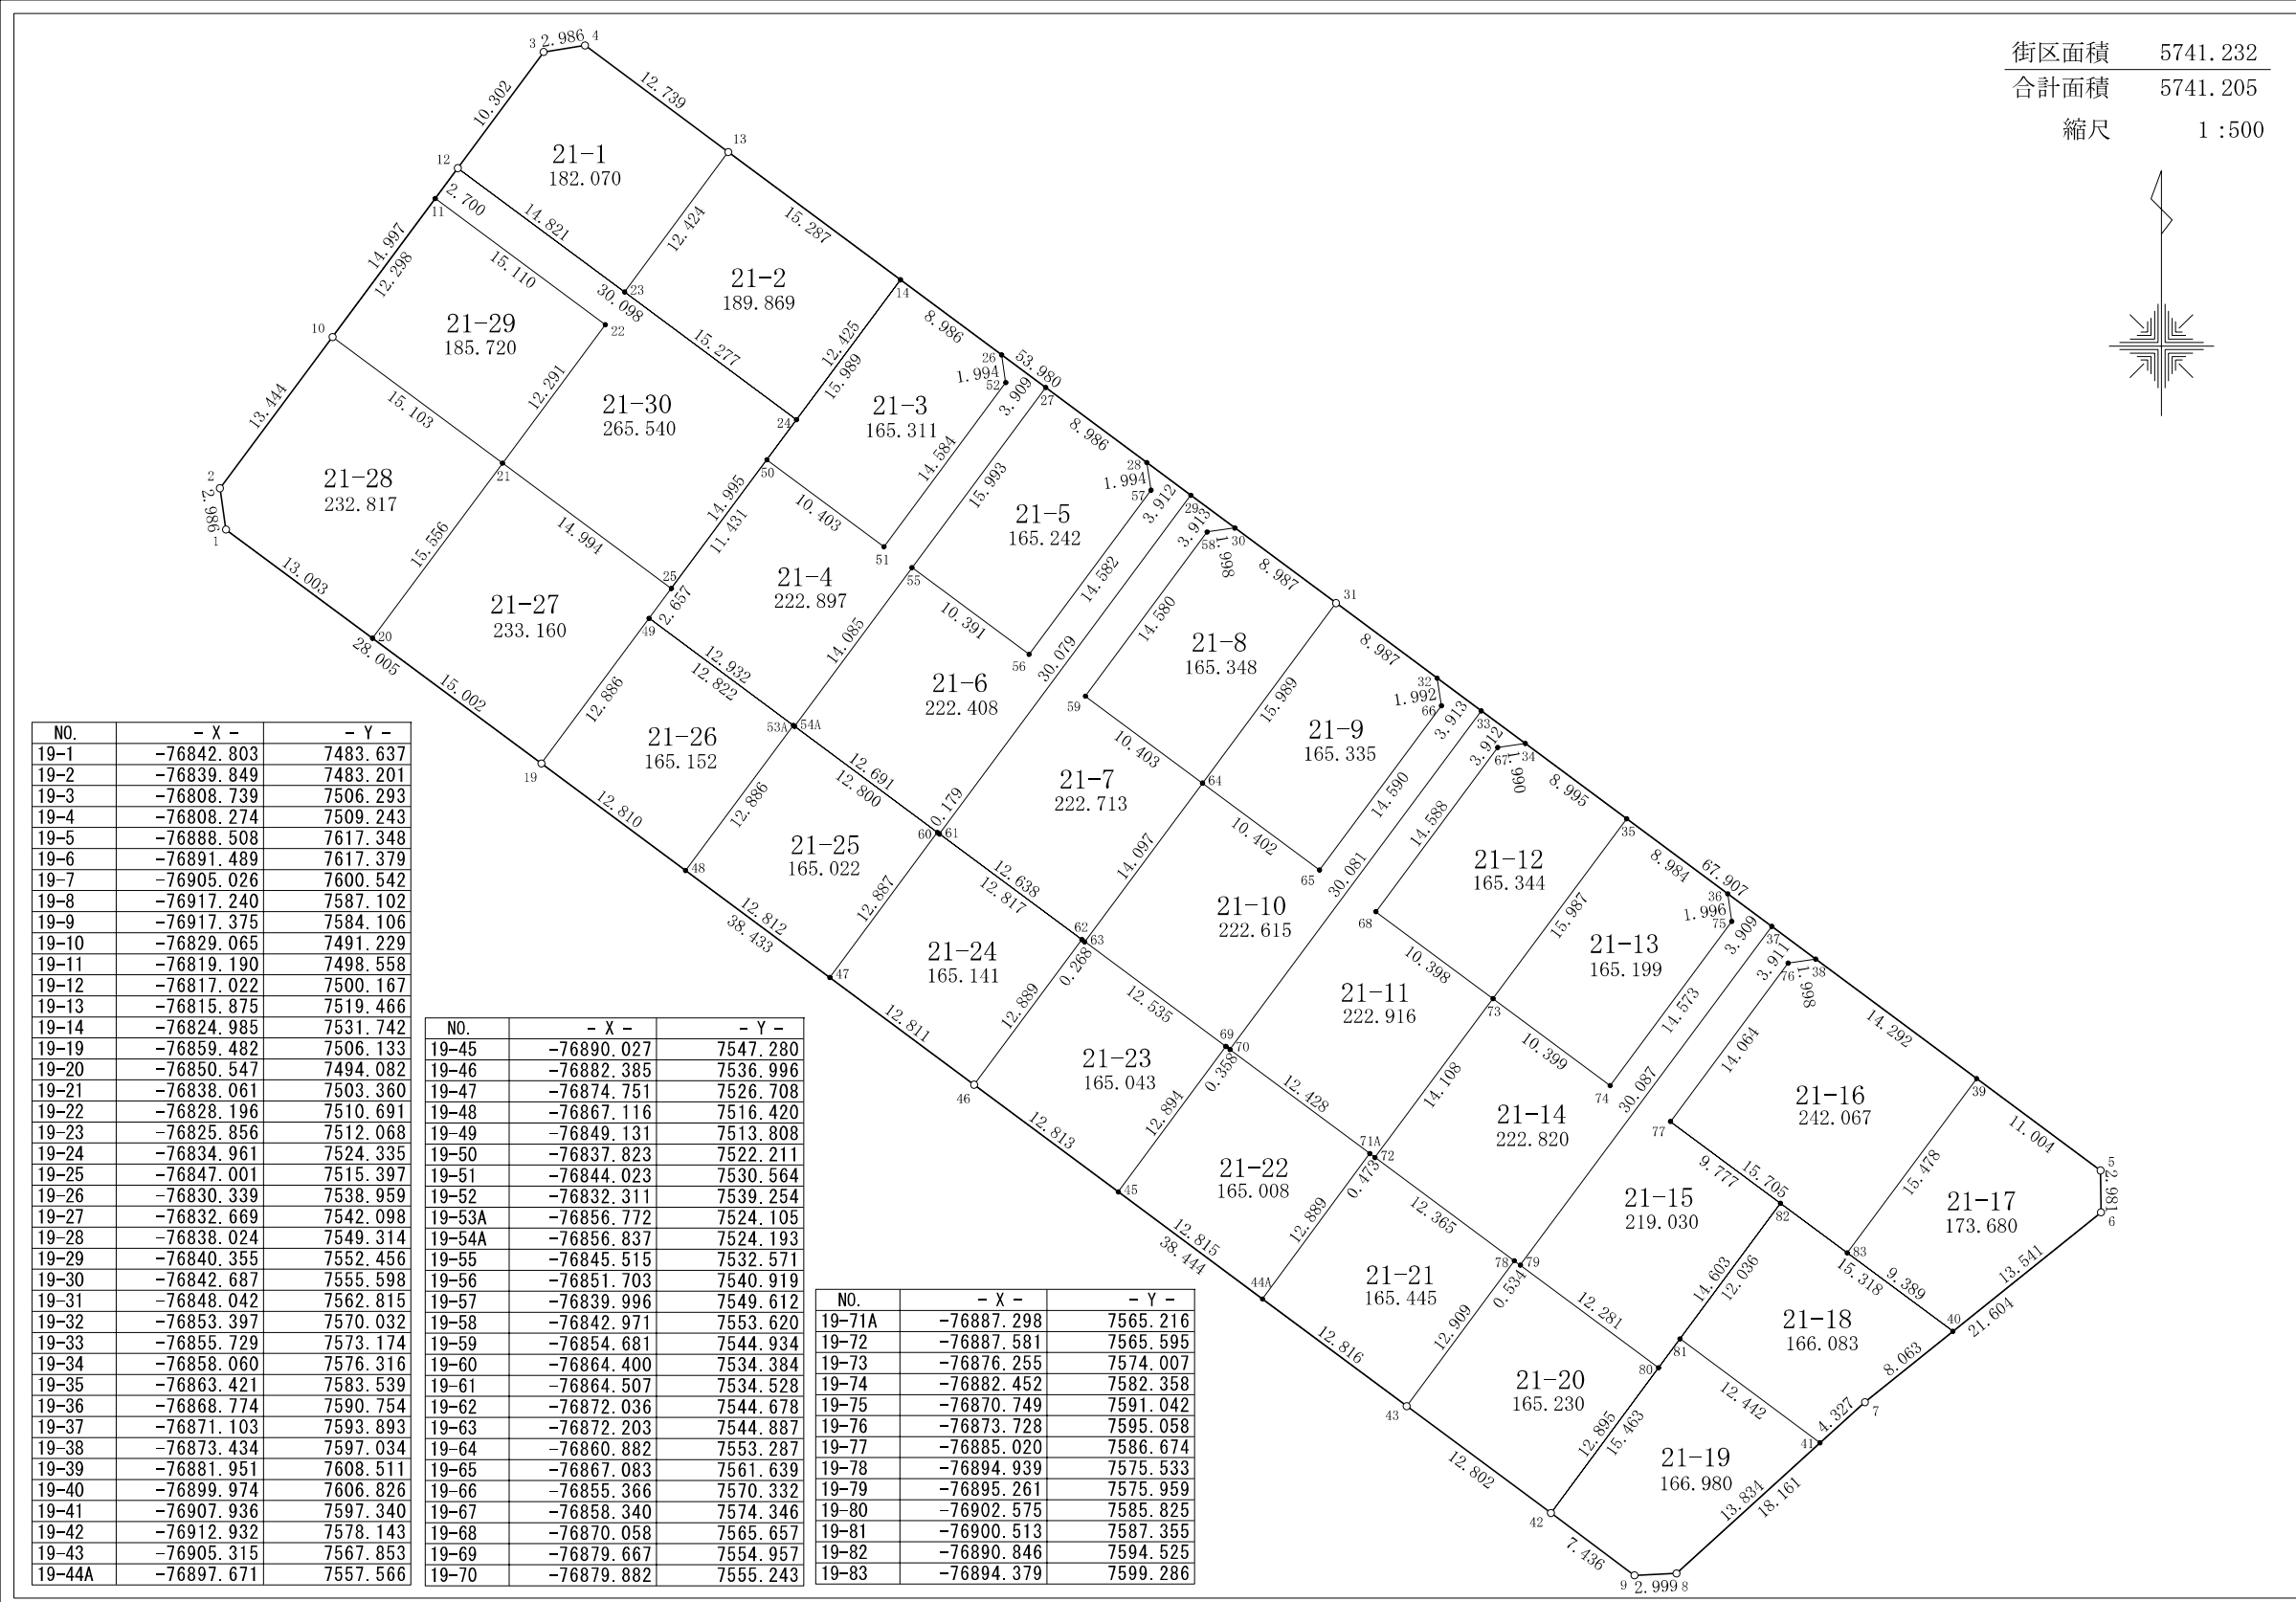


君津市 郡地区 画地出来形原子

郡一丁目21番

日付 平成21年12月18日

街区面積 5741.232
 合計面積 5741.205
 縮尺 1:500

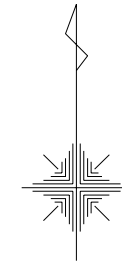

NO.	- X -	- Y -
19-1	-76842.803	7483.637
19-2	-76839.849	7483.201
19-3	-76808.739	7506.293
19-4	-76808.274	7509.243
19-5	-76888.508	7617.348
19-6	-76891.489	7617.379
19-7	-76905.026	7600.542
19-8	-76917.240	7587.102
19-9	-76917.375	7584.106
19-10	-76829.065	7491.229
19-11	-76819.190	7498.558
19-12	-76817.022	7500.167
19-13	-76815.875	7519.466
19-14	-76824.985	7531.742
19-19	-76859.482	7506.133
19-20	-76850.547	7494.082
19-21	-76838.061	7503.360
19-22	-76828.196	7510.691
19-23	-76825.856	7512.068
19-24	-76834.961	7524.335
19-25	-76847.001	7515.397
19-26	-76830.339	7538.959
19-27	-76832.669	7542.098
19-28	-76838.024	7549.314
19-29	-76840.355	7552.456
19-30	-76842.687	7555.598
19-31	-76848.042	7562.815
19-32	-76853.397	7570.032
19-33	-76855.729	7573.174
19-34	-76858.060	7576.316
19-35	-76863.421	7583.539
19-36	-76868.774	7590.754
19-37	-76871.103	7593.893
19-38	-76873.434	7597.034
19-39	-76881.951	7608.511
19-40	-76899.974	7606.826
19-41	-76907.936	7597.340
19-42	-76912.932	7578.143
19-43	-76905.315	7567.853
19-44A	-76897.671	7557.566

NO.	- X -	- Y -
19-45	-76890.027	7547.280
19-46	-76882.385	7536.996
19-47	-76874.751	7526.708
19-48	-76867.116	7516.420
19-49	-76849.131	7513.808
19-50	-76837.823	7522.211
19-51	-76844.023	7530.564
19-52	-76832.311	7539.254
19-53A	-76856.772	7524.105
19-54A	-76856.837	7524.193
19-55	-76845.515	7532.571
19-56	-76851.703	7540.919
19-57	-76839.996	7549.612
19-58	-76842.971	7553.620
19-59	-76854.681	7544.934
19-60	-76864.400	7534.384
19-61	-76864.507	7534.528
19-62	-76872.036	7544.678
19-63	-76872.203	7544.887
19-64	-76860.882	7553.287
19-65	-76867.083	7561.639
19-66	-76855.366	7570.332
19-67	-76858.340	7574.346
19-68	-76870.058	7565.657
19-69	-76879.667	7554.957
19-70	-76879.882	7555.243

NO.	- X -	- Y -
19-71A	-76887.298	7565.216
19-72	-76887.581	7565.595
19-73	-76876.255	7574.007
19-74	-76882.452	7582.358
19-75	-76870.749	7591.042
19-76	-76873.728	7595.058
19-77	-76885.020	7586.674
19-78	-76894.939	7575.533
19-79	-76895.261	7575.959
19-80	-76902.575	7585.825
19-81	-76900.513	7587.355
19-82	-76890.846	7594.525
19-83	-76894.379	7599.286

現地とは必ずしも一致しないことがあります。あくまで参考図としてご利用ください。
 資料（写し）によって発生した直接または間接の損失、損害等について市では一切の責任を負いません。