
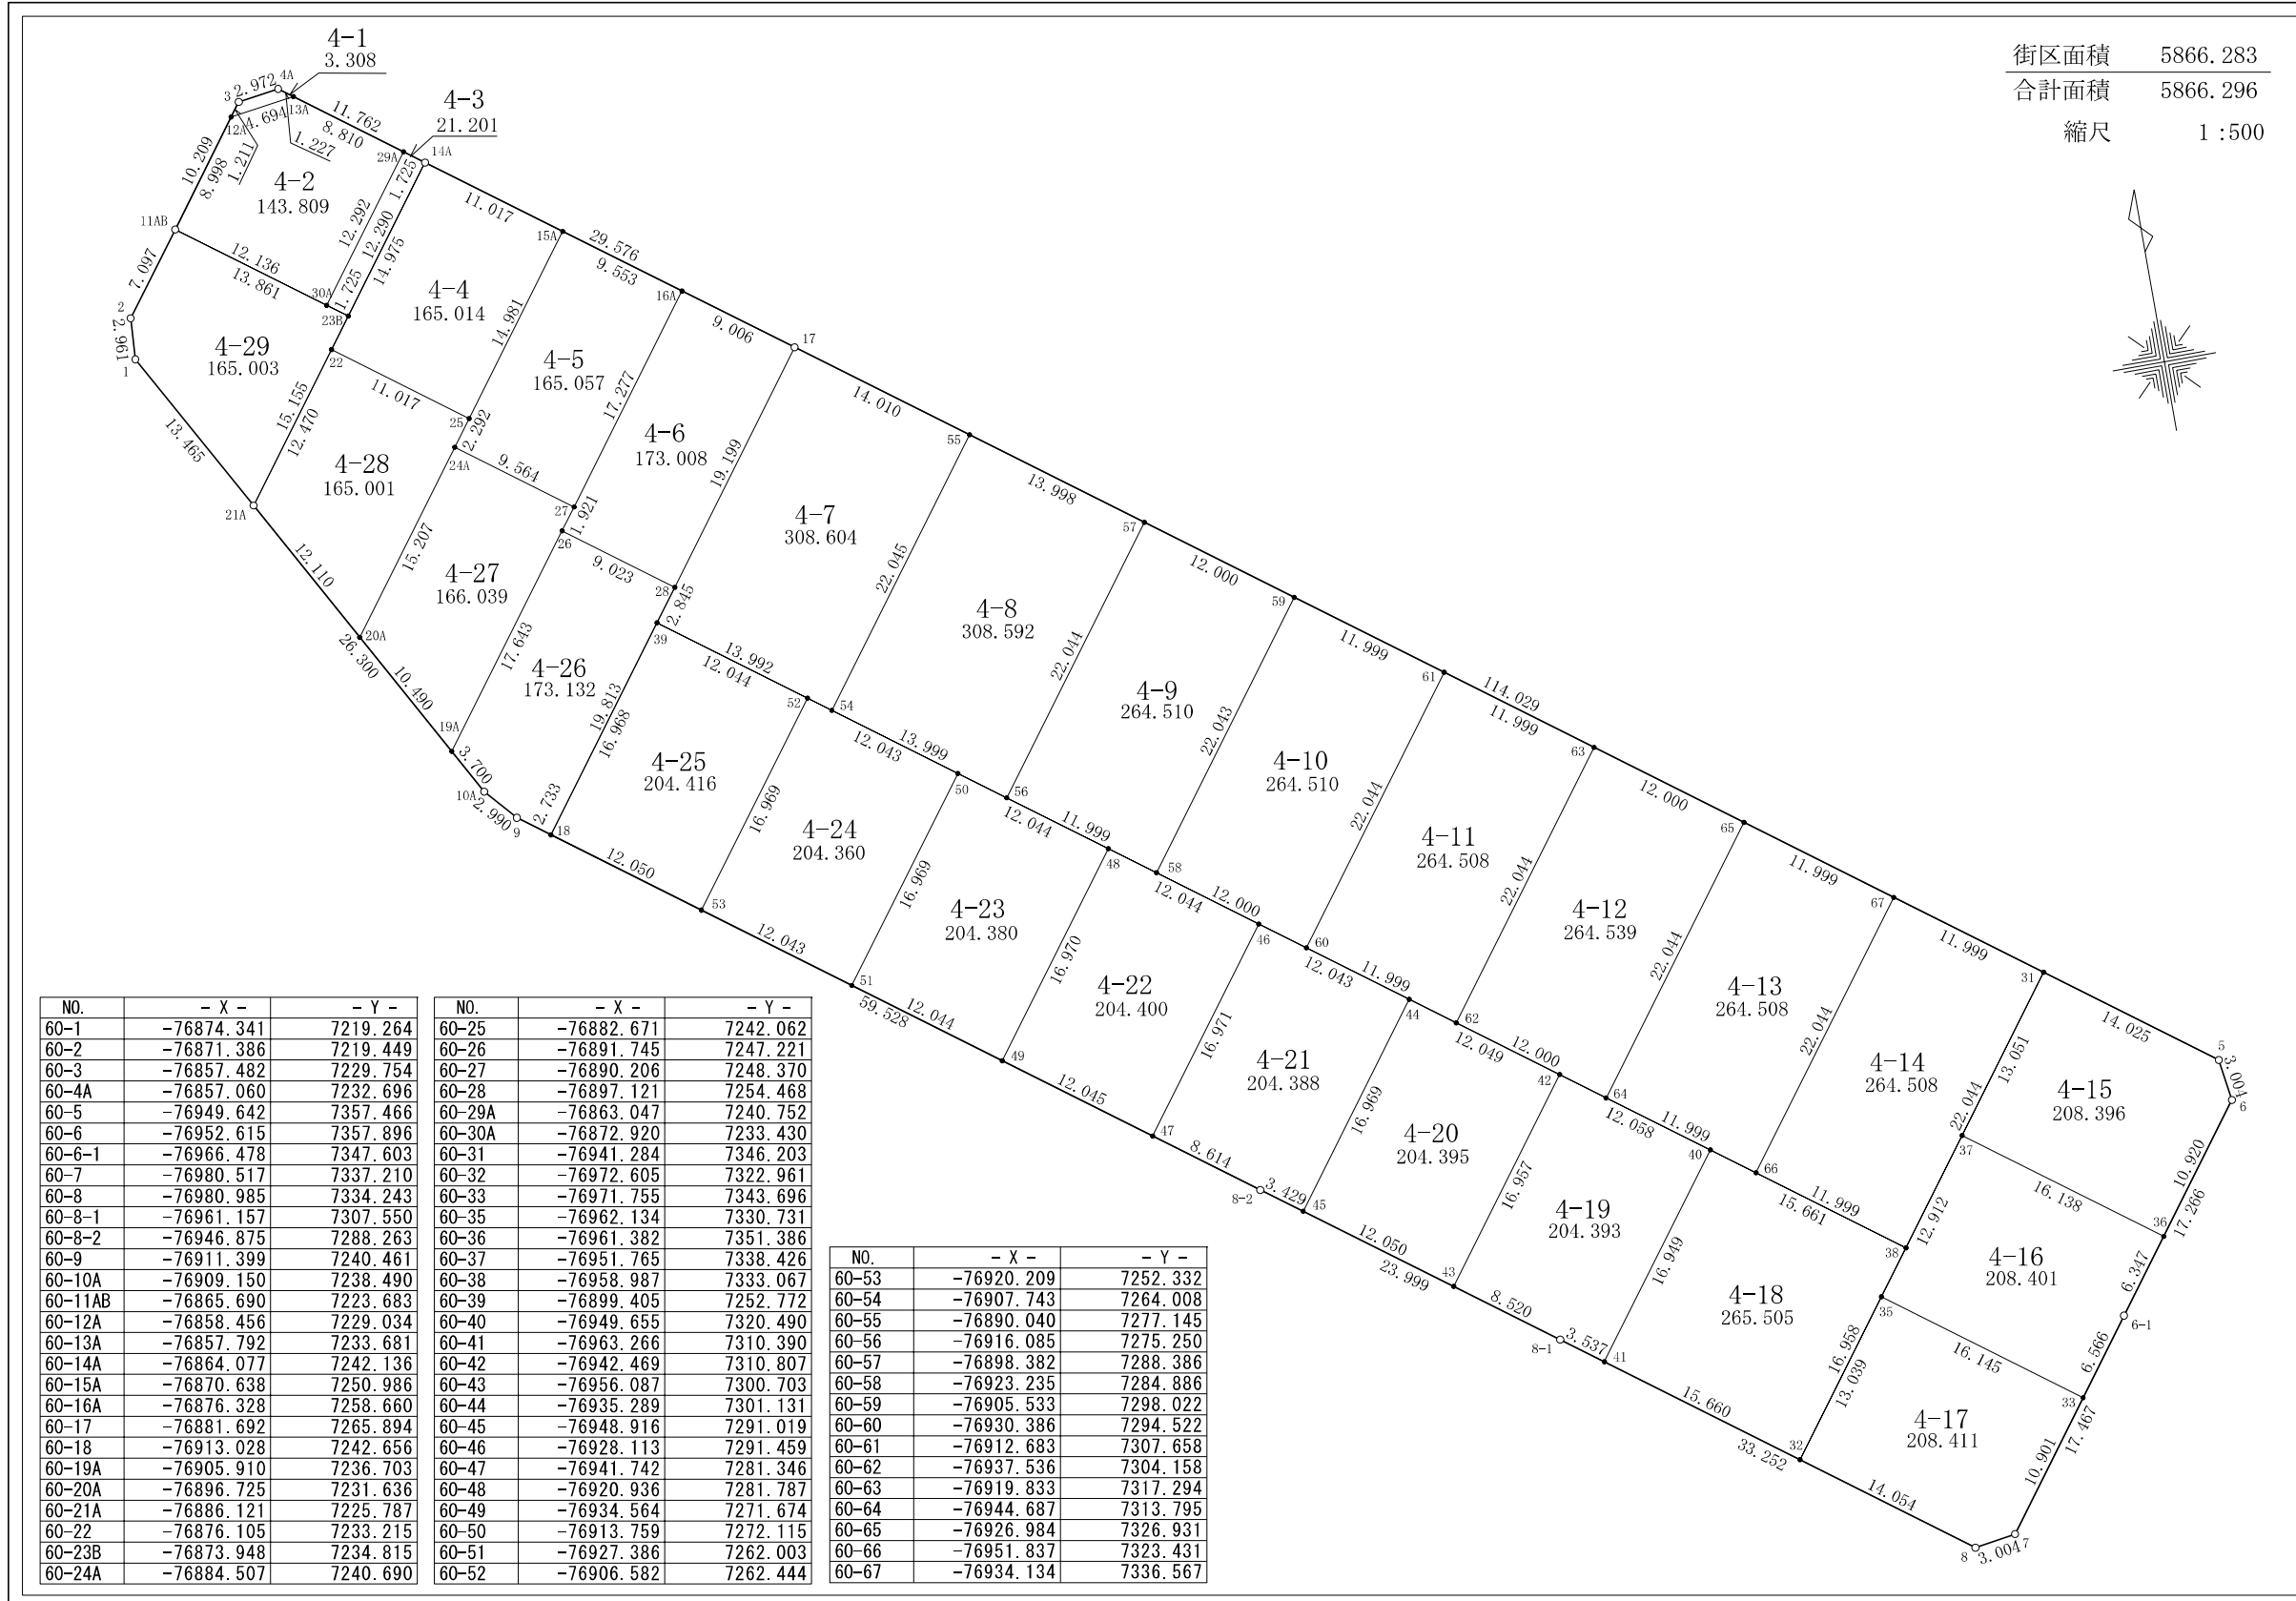


君津市 郡地区 画地出来形原子

郡二丁目4番

日付 平成21年12月18日

街区面積 5866.283  
 合計面積 5866.296  
 縮尺 1:500

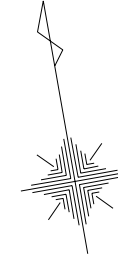

NO.	- X -	- Y -
60-1	-76874.341	7219.264
60-2	-76871.386	7219.449
60-3	-76857.482	7229.754
60-4A	-76857.060	7232.696
60-5	-76949.642	7357.466
60-6	-76952.615	7357.896
60-6-1	-76966.478	7347.603
60-7	-76980.517	7337.210
60-8	-76980.985	7334.243
60-8-1	-76961.157	7307.550
60-8-2	-76946.875	7288.263
60-9	-76911.399	7240.461
60-10A	-76909.150	7238.490
60-11AB	-76865.690	7223.683
60-12A	-76858.456	7229.034
60-13A	-76857.792	7233.681
60-14A	-76864.077	7242.136
60-15A	-76870.638	7250.986
60-16A	-76876.328	7258.660
60-17	-76881.692	7265.894
60-18	-76913.028	7242.656
60-19A	-76905.910	7236.703
60-20A	-76896.725	7231.636
60-21A	-76886.121	7225.787
60-22	-76876.105	7233.215
60-23B	-76873.948	7234.815
60-24A	-76884.507	7240.690

NO.	- X -	- Y -
60-25	-76882.671	7242.062
60-26	-76891.745	7247.221
60-27	-76890.206	7248.370
60-28	-76897.121	7254.468
60-29A	-76863.047	7240.752
60-30A	-76872.920	7233.430
60-31	-76941.284	7346.203
60-32	-76972.605	7322.961
60-33	-76971.755	7343.696
60-35	-76962.134	7330.731
60-36	-76961.382	7351.386
60-37	-76951.765	7338.426
60-38	-76958.987	7333.067
60-39	-76899.405	7252.772
60-40	-76949.655	7320.490
60-41	-76963.266	7310.390
60-42	-76942.469	7310.807
60-43	-76956.087	7300.703
60-44	-76935.289	7301.131
60-45	-76948.916	7291.019
60-46	-76928.113	7291.459
60-47	-76941.742	7281.346
60-48	-76920.936	7281.787
60-49	-76934.564	7271.674
60-50	-76913.759	7272.115
60-51	-76927.386	7262.003
60-52	-76906.582	7262.444

NO.	- X -	- Y -
60-53	-76920.209	7252.332
60-54	-76907.743	7264.008
60-55	-76890.040	7277.145
60-56	-76916.085	7275.250
60-57	-76898.382	7288.386
60-58	-76923.235	7284.886
60-59	-76905.533	7298.022
60-60	-76930.386	7294.522
60-61	-76912.683	7307.658
60-62	-76937.536	7304.158
60-63	-76919.833	7317.294
60-64	-76944.687	7313.795
60-65	-76926.984	7326.931
60-66	-76951.837	7323.431
60-67	-76934.134	7336.567

現地とは必ずしも一致しないことがあります。あくまで参考図としてご利用ください。  
 資料（写し）によって発生した直接または間接の損失、損害等について市では一切の責任を負いません。