
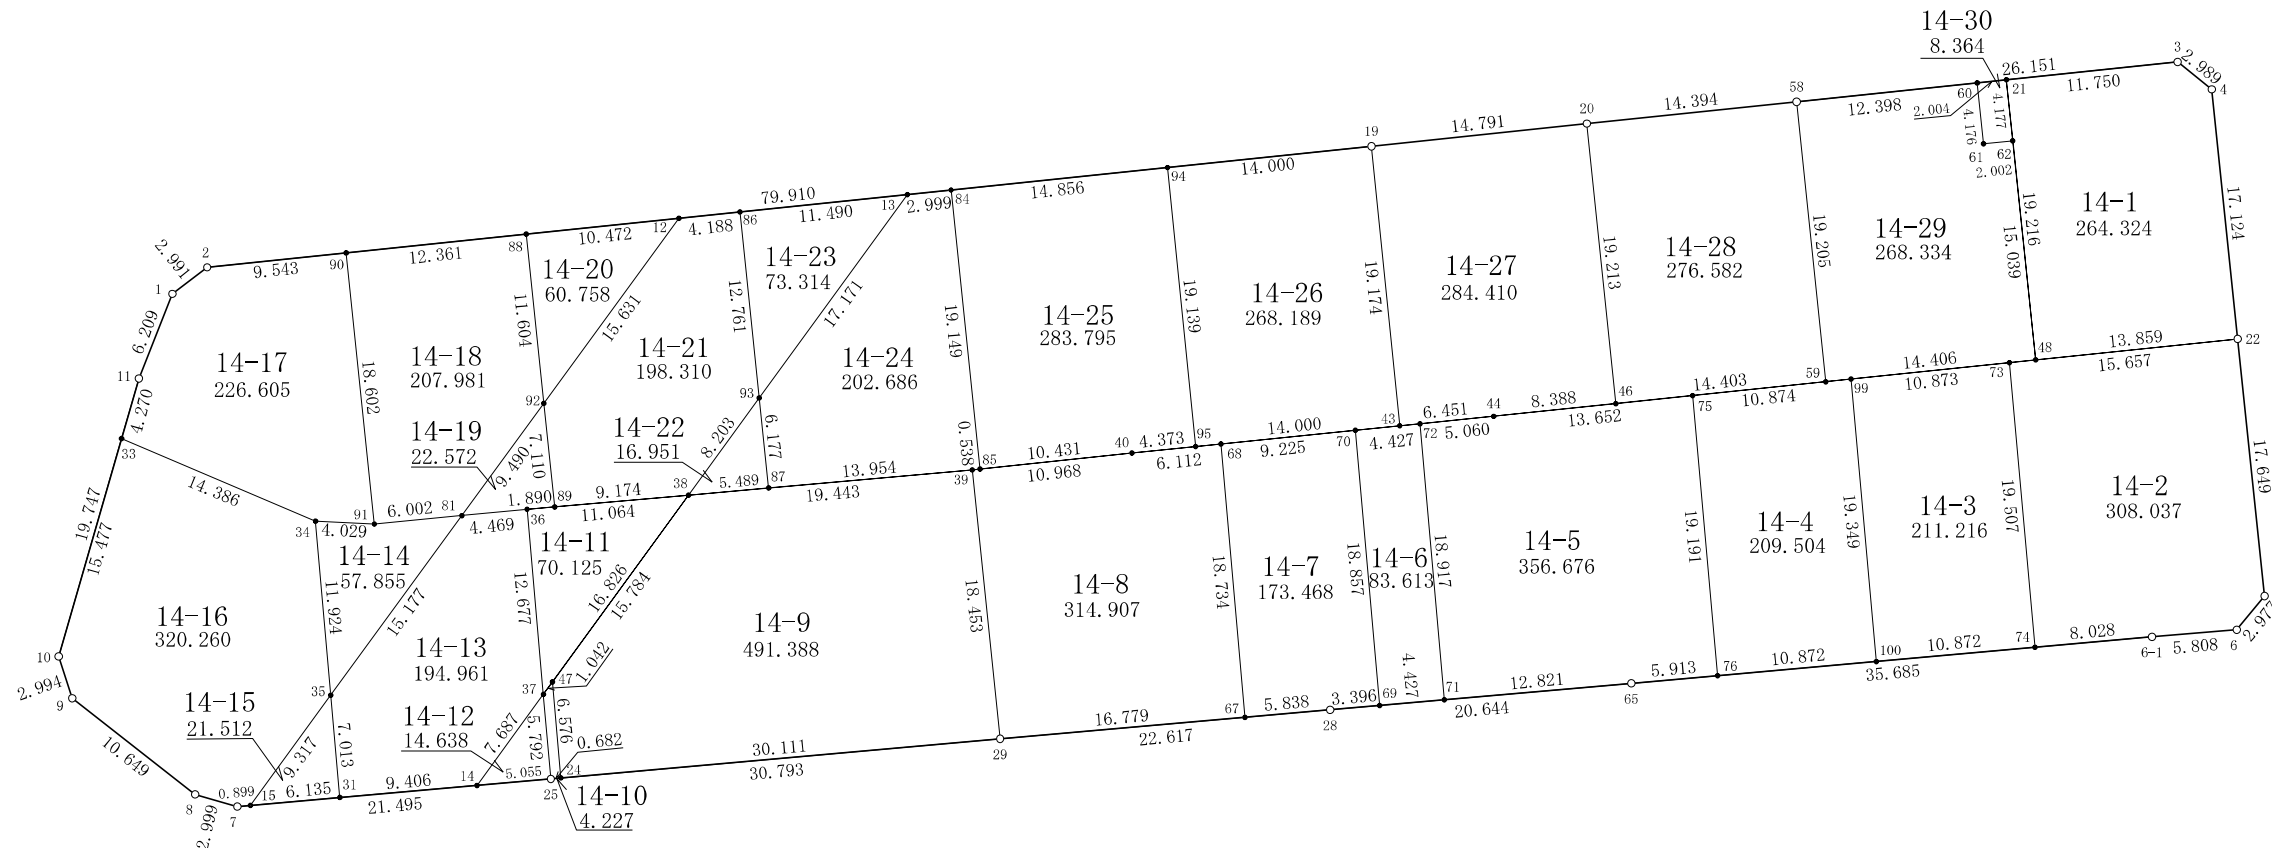


君津市 郡地区 画地出来形原子

郡二丁目14番

日付 平成21年12月18日

街区面積 5495.589
 合計面積 5495.562
 縮尺 1:500

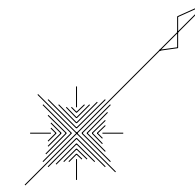

NO.	- X -	- Y -
53-1	-77157.585	7374.273
53-2	-77154.621	7374.675
53-3	-77049.588	7459.879
53-4	-77049.261	7462.850
53-5	-77071.171	7489.852
53-6	-77074.134	7490.141
53-6-1	-77078.567	7486.389
53-7	-77179.196	7402.150
53-8	-77180.640	7399.522
53-9	-77181.931	7388.952
53-10	-77180.570	7386.285
53-11	-77163.282	7376.742
53-12	-77129.484	7395.080
53-13	-77117.311	7404.961
53-14	-77166.593	7412.707
53-15	-77178.507	7402.727
53-19	-77092.578	7425.037
53-20	-77081.079	7434.340
53-21	-77058.717	7452.482

NO.	- X -	- Y -
53-22	-77060.060	7476.140
53-24	-77162.195	7416.391
53-25	-77162.718	7415.953
53-28	-77121.770	7450.244
53-29	-77139.097	7435.708
53-31	-77173.804	7406.667
53-33	-77167.020	7378.806
53-34	-77161.644	7392.150
53-35	-77169.301	7401.291
53-36	-77150.858	7401.796
53-37	-77158.999	7411.513
53-38	-77142.377	7408.901
53-39	-77127.468	7421.381
53-40	-77118.938	7428.276
53-43	-77104.702	7439.891
53-44	-77099.704	7443.969
53-46	-77093.191	7449.254
53-47	-77157.970	7411.352
53-48	-77070.821	7467.407

NO.	- X -	- Y -
53-58	-77069.907	7443.416
53-59	-77082.007	7458.330
53-60	-77060.274	7451.221
53-61	-77062.903	7454.465
53-62	-77061.348	7455.726
53-65	-77105.947	7463.504
53-67	-77126.243	7446.492
53-68	-77114.202	7432.140
53-69	-77119.167	7452.425
53-70	-77107.055	7437.972
53-71	-77115.774	7455.269
53-72	-77103.624	7440.770
53-73	-77072.217	7466.274
53-74	-77084.727	7481.241
53-75	-77089.103	7452.571
53-76	-77101.410	7467.296
53-81	-77154.305	7398.952
53-84	-77114.982	7406.851
53-85	-77127.050	7421.719

NO.	- X -	- Y -
53-86	-77126.232	7397.719
53-87	-77138.167	7412.423
53-88	-77137.615	7388.480
53-89	-77149.409	7403.009
53-90	-77147.212	7380.689
53-91	-77158.935	7395.132
53-92	-77144.928	7397.489
53-93	-77134.274	7407.627
53-94	-77103.448	7416.214
53-95	-77115.550	7431.041
53-99	-77080.660	7459.423
53-100	-77093.069	7474.269

現地とは必ずしも一致しないことがあります。あくまで参考図としてご利用ください。
 資料（写し）によって発生した直接または間接の損失、損害等について市では一切の責任を負いません。