

君津市 郡地区 画地出来形原子



郡三丁目13番

日付 平成21年12月18日

街区面積 4446.196

合計面積 4446.199

縮尺 1:500

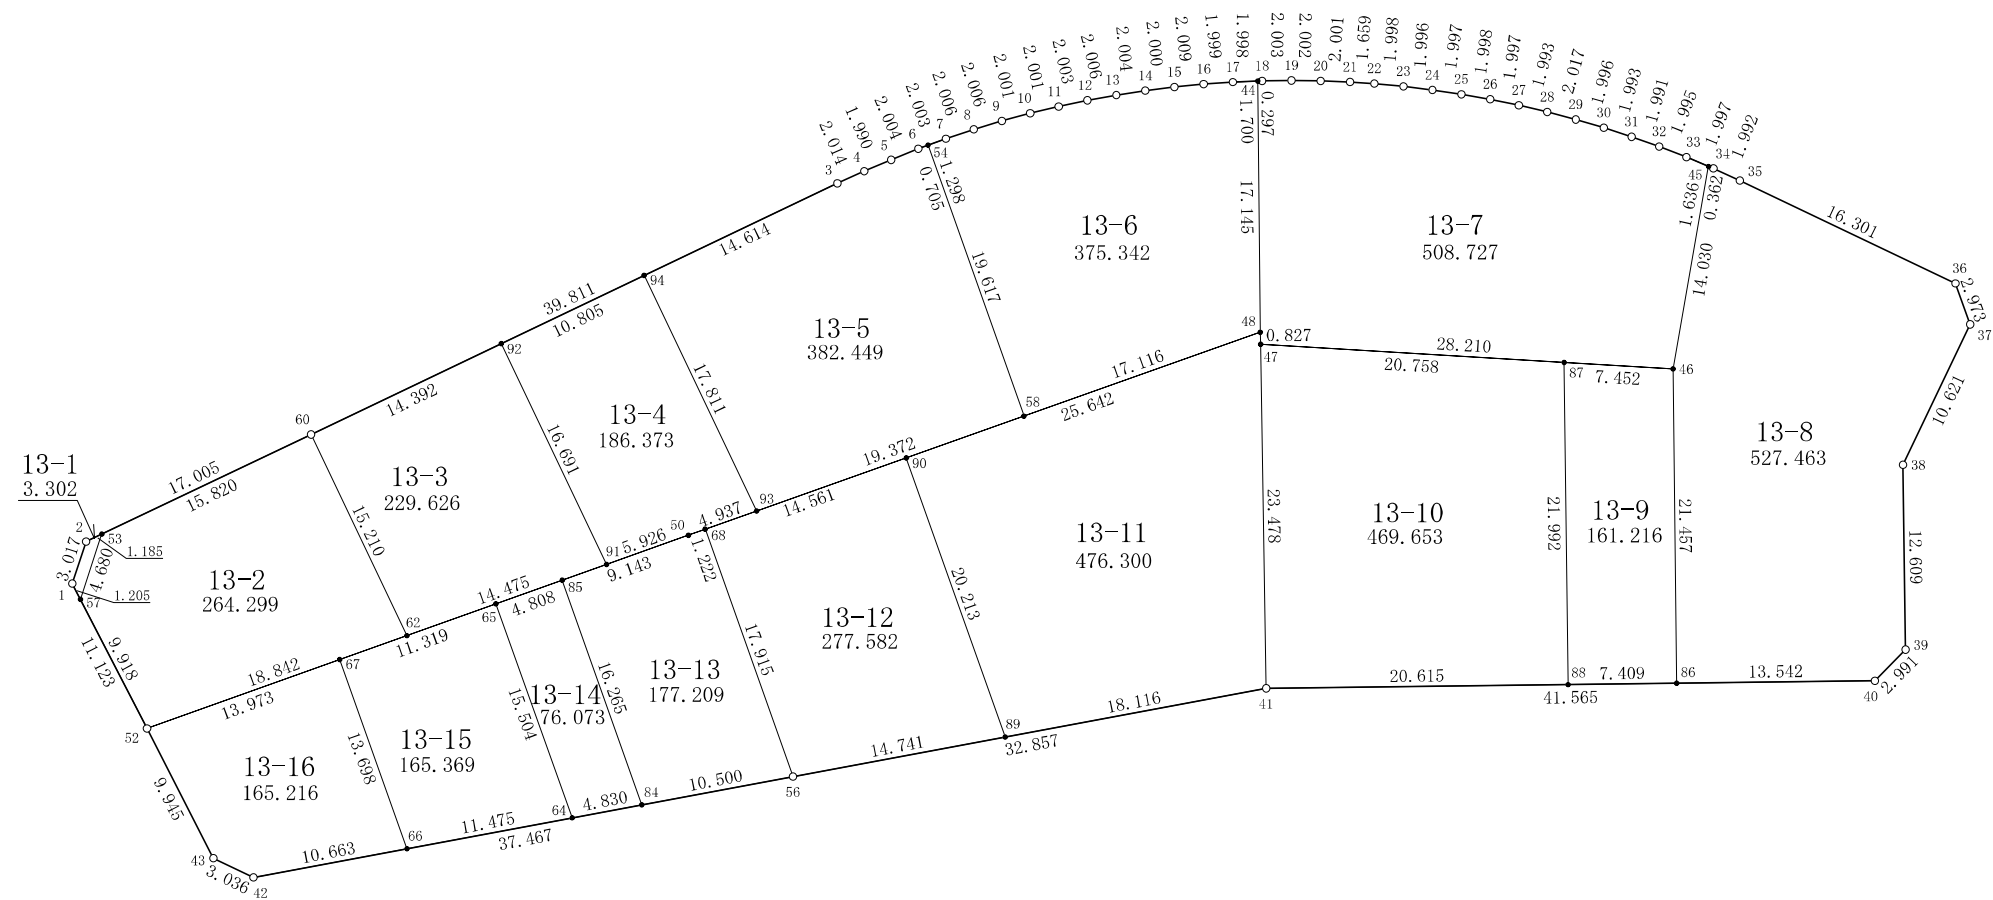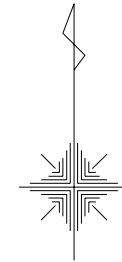

NO.	- X -	- Y -	NO.	- X -	- Y -	NO.	- X -	- Y -	NO.	- X -	- Y -	NO.	- X -	- Y -
33-1	-77000.861	7768.015	33-18	-76966.554	7849.236	33-35	-76973.352	7881.857	33-54	-76970.941	7826.428	33-90	-76992.282	7824.944
33-2	-76997.994	7768.955	33-19	-76966.526	7851.239	33-36	-76980.375	7896.568	33-56	-77014.034	7817.210	33-91	-76999.551	7804.488
33-3	-76973.540	7820.240	33-20	-76966.554	7853.241	33-37	-76983.173	7897.574	33-57	-77001.932	7768.567	33-92	-76984.487	7797.299
33-4	-76972.712	7822.076	33-21	-76966.629	7855.241	33-38	-76992.756	7892.994	33-58	-76989.432	7832.980	33-93	-76995.908	7814.722
33-5	-76971.944	7823.912	33-22	-76966.740	7856.896	33-39	-77005.364	7893.164	33-60	-76990.686	7784.310	33-94	-76979.834	7807.051
33-6	-76971.180	7825.765	33-23	-76966.927	7858.885	33-40	-77007.501	7891.072	33-62	-77004.416	7790.855			
33-7	-76970.500	7827.649	33-24	-76967.175	7860.866	33-41	-77008.012	7849.510	33-64	-77016.850	7802.141			
33-8	-76969.867	7829.552	33-25	-76967.466	7862.842	33-42	-77020.916	7780.380	33-65	-77002.248	7796.930			
33-9	-76969.290	7831.473	33-26	-76967.809	7864.810	33-43	-77019.599	7777.645	33-66	-77018.957	7790.861			
33-10	-76968.761	7833.403	33-27	-76968.217	7866.765	33-44	-76966.566	7848.939	33-67	-77006.052	7786.269			
33-11	-76968.299	7835.350	33-28	-76968.671	7868.706	33-45	-76972.391	7879.709	33-68	-76997.150	7811.221			
33-12	-76967.881	7837.309	33-29	-76969.189	7870.655	33-46	-76986.211	7877.292	33-84	-77015.963	7806.889			
33-13	-76967.521	7839.282	33-30	-76969.752	7872.570	33-47	-76984.537	7849.132	33-85	-77000.632	7801.458			
33-14	-76967.221	7841.263	33-31	-76970.366	7874.466	33-48	-76983.710	7849.111	33-86	-77007.667	7877.531			
33-15	-76966.969	7843.247	33-32	-76971.031	7876.343	33-50	-76997.559	7810.069	33-87	-76985.769	7869.853			
33-16	-76966.771	7845.246	33-33	-76971.755	7878.202	33-52	-77010.749	7773.109	33-88	-77007.759	7870.123			
33-17	-76966.636	7847.240	33-34	-76972.532	7880.042	33-53	-76997.485	7770.025	33-89	-77011.332	7831.701			

大和測量株式会社

現地とは必ずしも一致しないことがあります。あくまで参考図としてご利用ください。
資料（写し）によって発生した直接または間接の損失、損害等について市では一切の責任を負いません。