
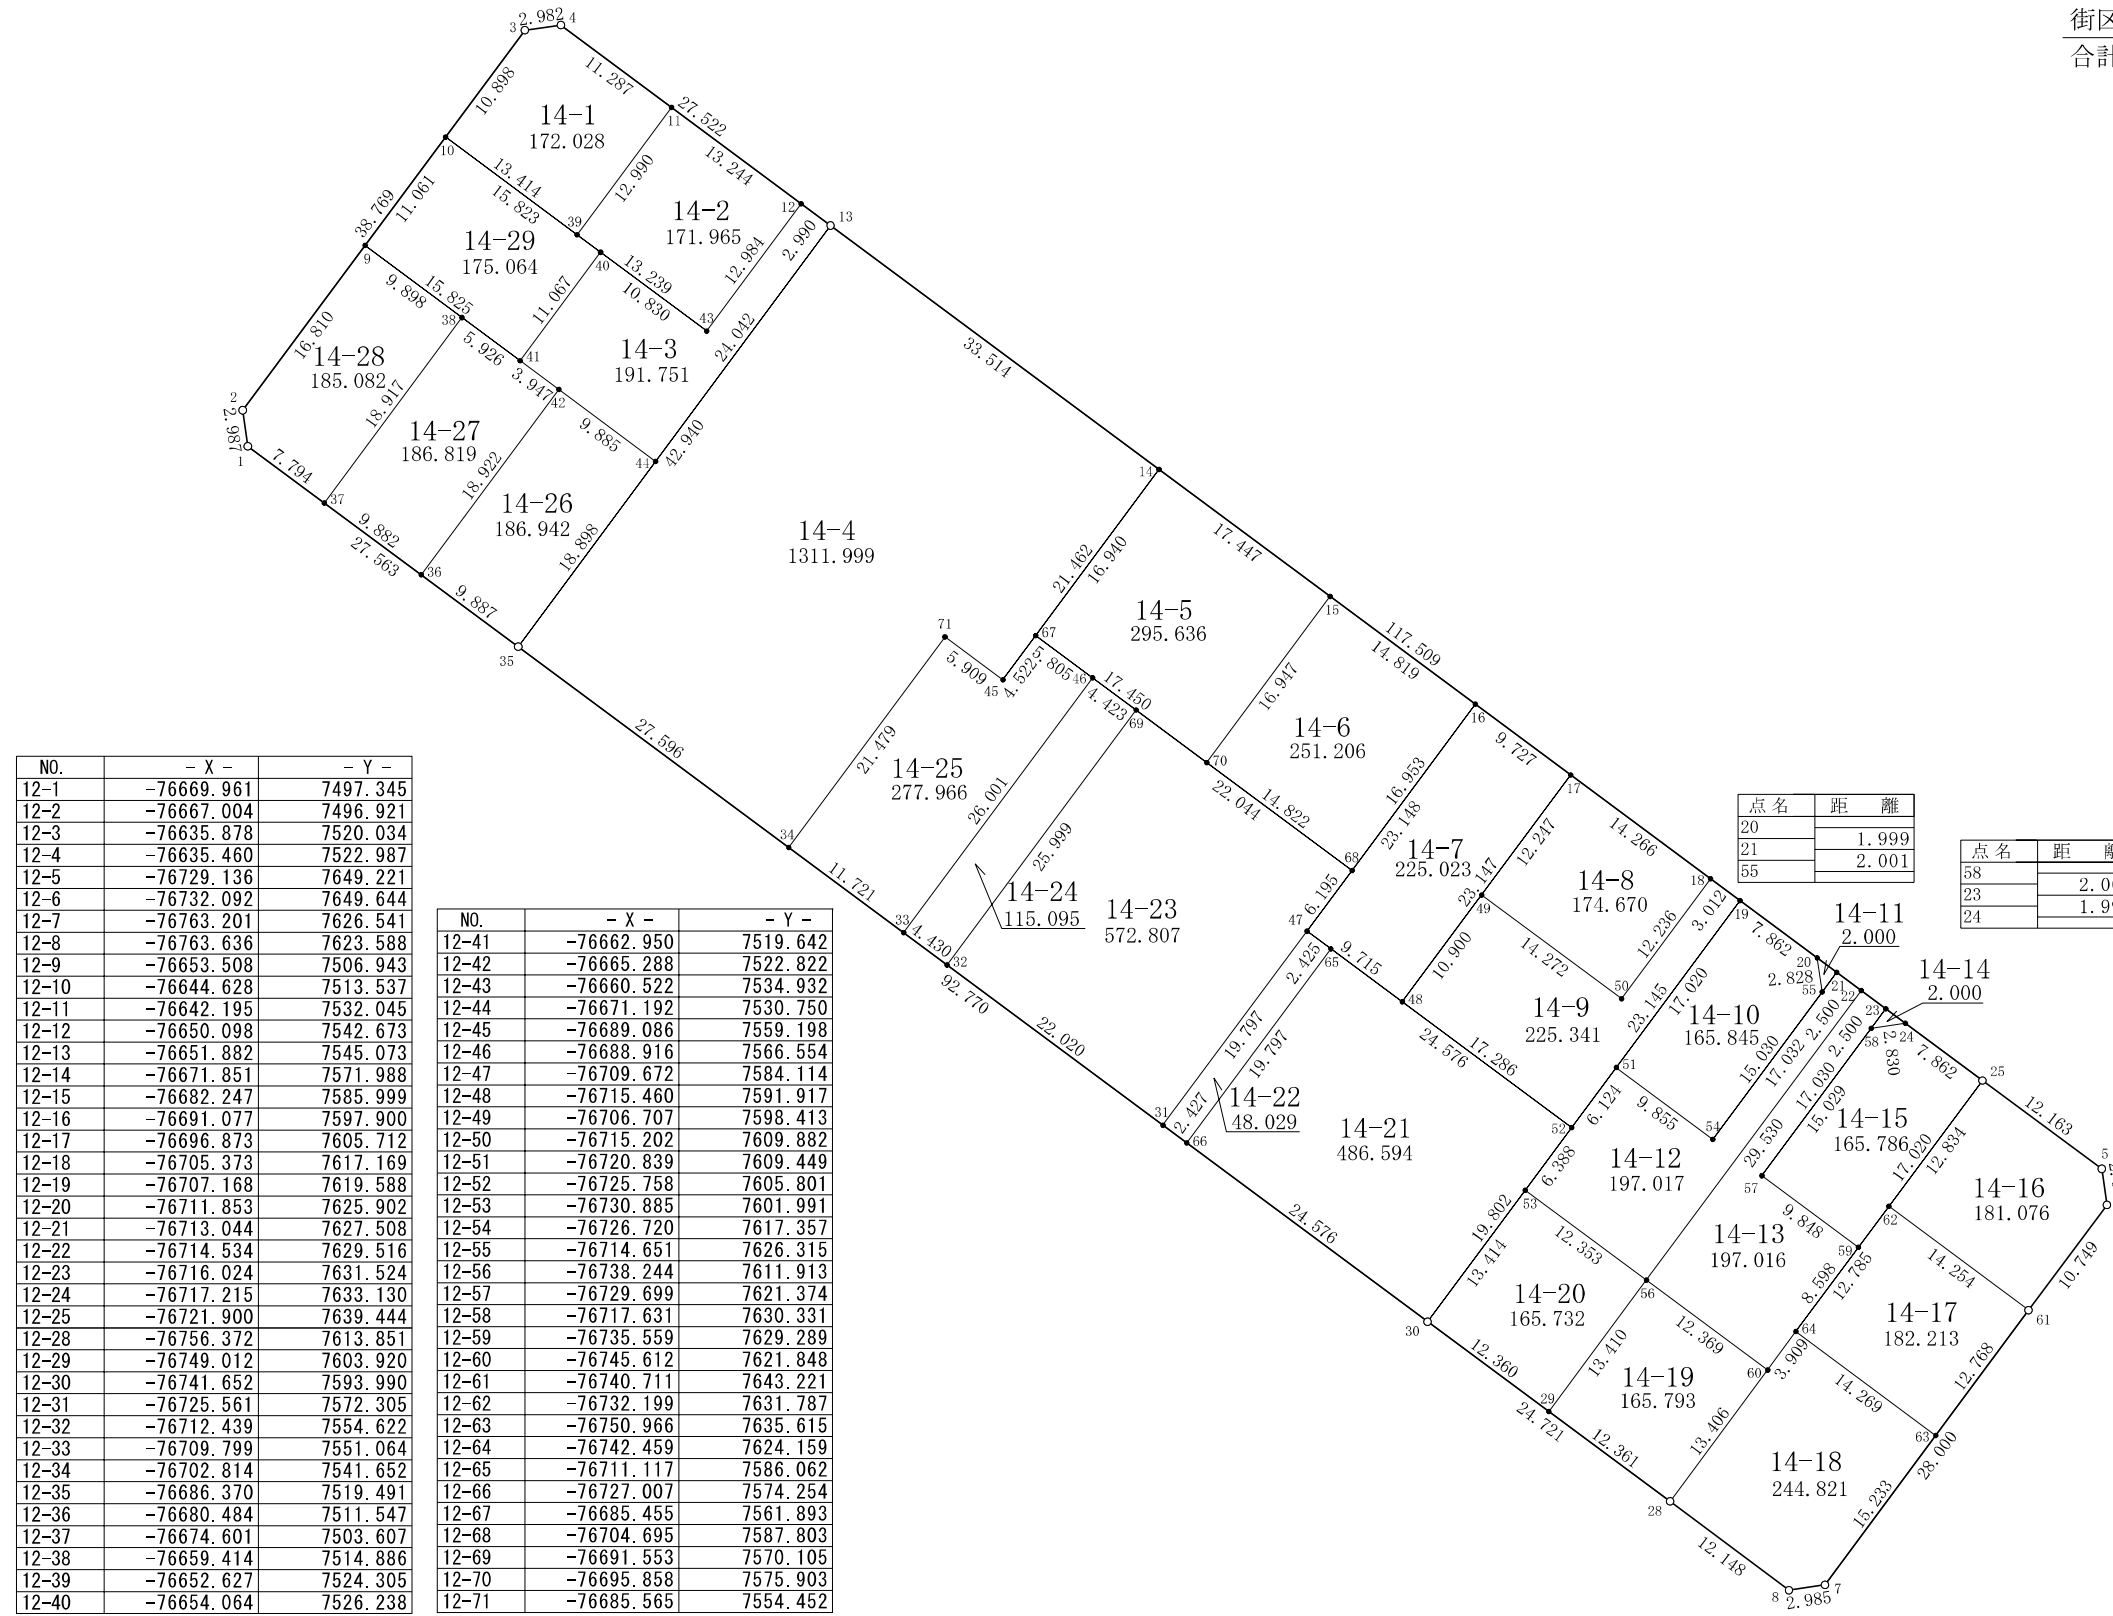


君津市 郡地区 画地出来形原子

郡一丁目14番

日付 平成21年12月18日

街区面積 6923.355
 合計面積 6923.316
 縮尺 1:600

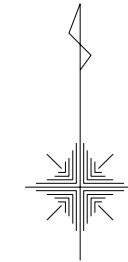

NO.	- X -	- Y -
12-1	-76669.961	7497.345
12-2	-76667.004	7496.921
12-3	-76635.878	7520.034
12-4	-76635.460	7522.987
12-5	-76729.136	7649.221
12-6	-76732.092	7649.644
12-7	-76763.201	7626.541
12-8	-76763.636	7623.588
12-9	-76653.508	7506.943
12-10	-76644.628	7513.537
12-11	-76642.195	7532.045
12-12	-76650.098	7542.673
12-13	-76651.882	7545.073
12-14	-76671.851	7571.988
12-15	-76682.247	7585.999
12-16	-76691.077	7597.900
12-17	-76696.873	7605.712
12-18	-76705.373	7617.169
12-19	-76707.168	7619.588
12-20	-76711.853	7625.902
12-21	-76713.044	7627.508
12-22	-76714.534	7629.516
12-23	-76716.024	7631.524
12-24	-76717.215	7633.130
12-25	-76721.900	7639.444
12-28	-76756.372	7613.851
12-29	-76749.012	7603.920
12-30	-76741.652	7593.990
12-31	-76725.561	7572.305
12-32	-76712.439	7554.622
12-33	-76709.799	7551.064
12-34	-76702.814	7541.652
12-35	-76686.370	7519.491
12-36	-76680.484	7511.547
12-37	-76674.601	7503.607
12-38	-76659.414	7514.886
12-39	-76652.627	7524.305
12-40	-76654.064	7526.238

NO.	- X -	- Y -
12-41	-76662.950	7519.642
12-42	-76665.288	7522.822
12-43	-76660.522	7534.932
12-44	-76671.192	7530.750
12-45	-76689.086	7559.198
12-46	-76688.916	7566.554
12-47	-76709.672	7584.114
12-48	-76715.460	7591.917
12-49	-76706.707	7598.413
12-50	-76715.202	7609.882
12-51	-76720.839	7609.449
12-52	-76725.758	7605.801
12-53	-76730.885	7601.991
12-54	-76726.720	7617.357
12-55	-76714.651	7626.315
12-56	-76738.244	7611.913
12-57	-76729.699	7621.374
12-58	-76717.631	7630.331
12-59	-76735.559	7629.289
12-60	-76745.612	7621.848
12-61	-76740.711	7643.221
12-62	-76732.199	7631.787
12-63	-76750.966	7635.615
12-64	-76742.459	7624.159
12-65	-76711.117	7586.062
12-66	-76727.007	7574.254
12-67	-76685.455	7561.893
12-68	-76704.695	7587.803
12-69	-76691.553	7570.105
12-70	-76695.858	7575.903
12-71	-76685.565	7554.452

点名	距離
20	1.999
21	2.001
55	2.001

点名	距離
58	2.001
23	1.999
24	1.999

現地とは必ずしも一致しないことがあります。あくまで参考図としてご利用ください。
 資料（写し）によって発生した直接または間接の損失、損害等について市では一切の責任を負いません。

大和測量株式会社