



君津市 中野 地区 画地原子

61 街区 日付 平成3年9月13日

NO.	- X -	- Y -
61#1	538.706	3156.045
61#2	541.562	155.167
61#3	632.203	187.854
61#4	634.614	193.351
61#5	624.365	217.360
61#6	618.876	219.823
61#7	525.050	184.904
61#8	523.986	182.099
61#9	525.418	179.203
61#10	526.756	176.445

NO.	- X -	- Y -
61#41	561.249	3198.376
61#42	560.105	197.950
61#43	559.576	197.754
61#44	558.268	197.266
61#45	552.346	195.063
61#46	547.482	193.270
61#47	546.928	193.064
61#48	537.692	189.628
61#49	535.809	188.927
61#50	534.798	188.551
61#51	530.673	168.820
61#52	540.747	172.567
61#53	540.930	172.636
61#54	541.757	172.943
61#55	543.640	173.644
61#56	543.964	173.764

街区面積 3562.864
合計面積 3562.832
縮尺 1:500

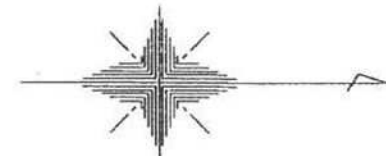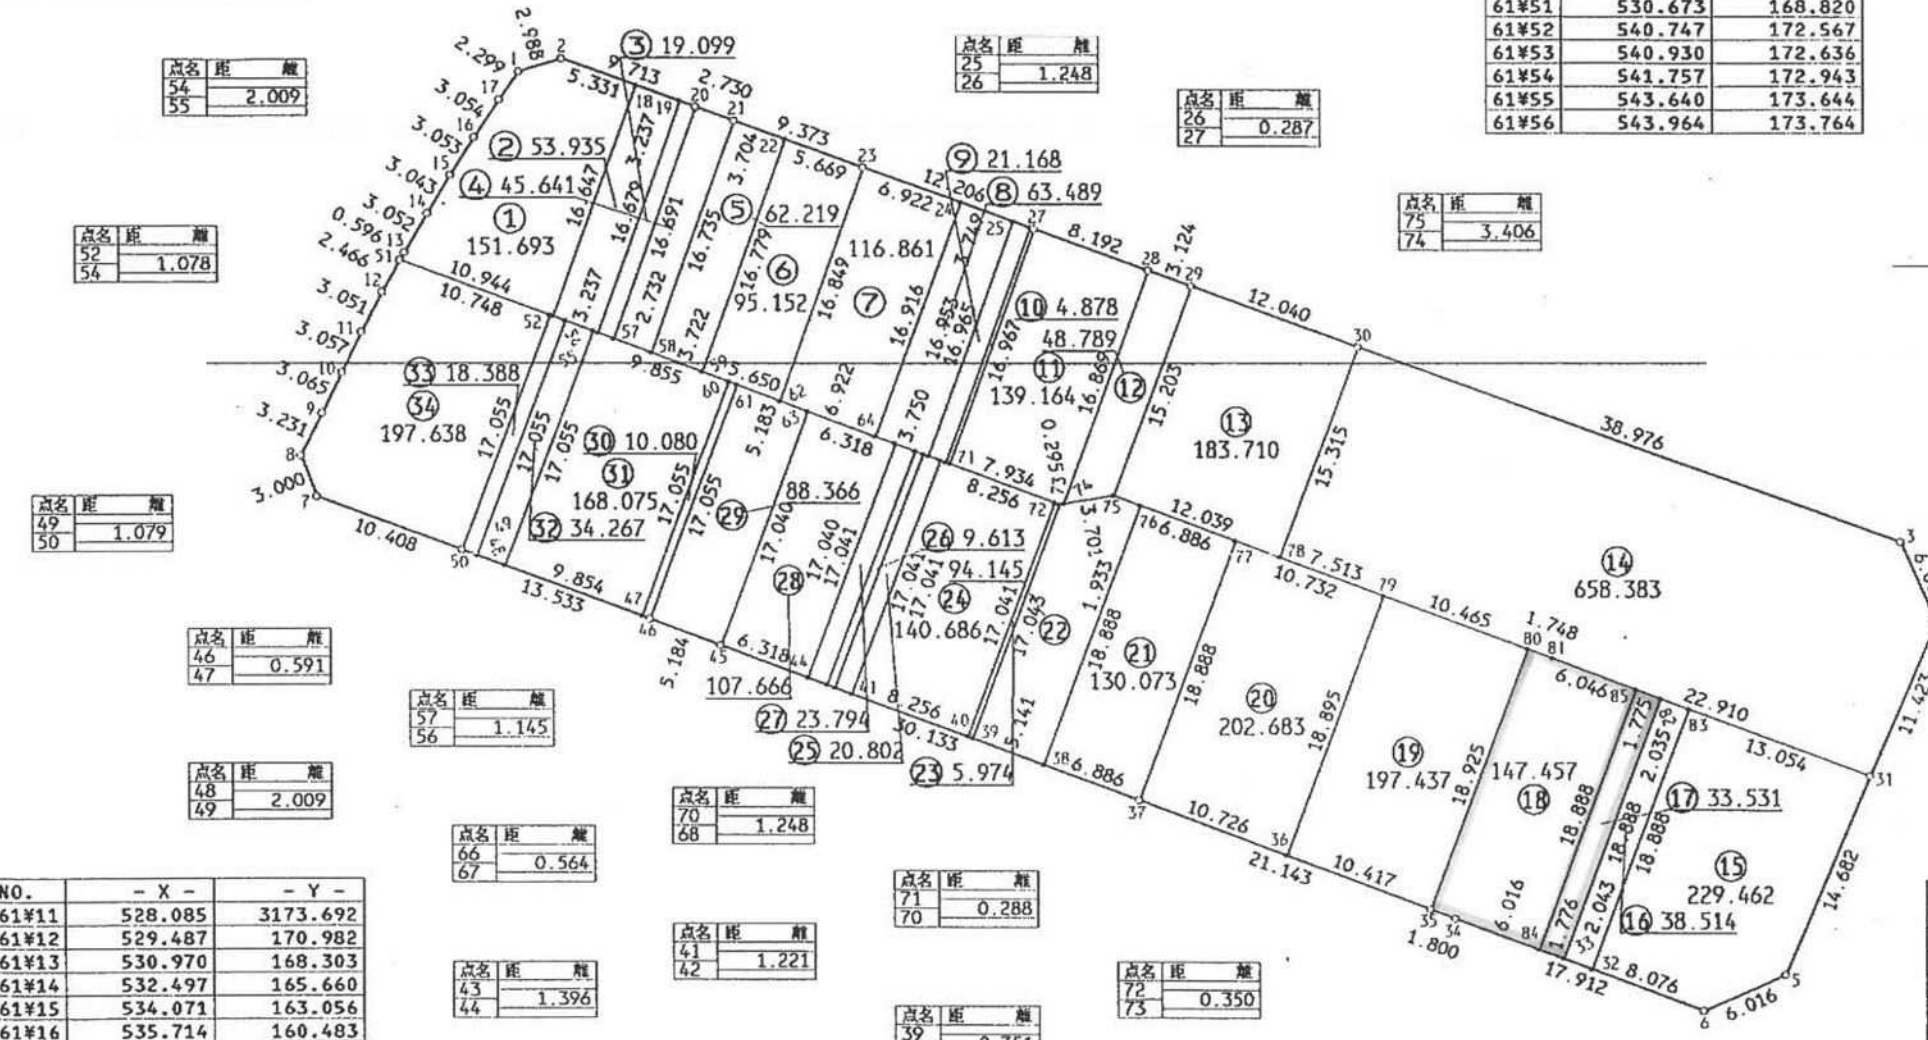

NO.	- X -	- Y -
61#11	528.085	3173.692
61#12	529.487	170.982
61#13	530.970	168.303
61#14	532.497	165.660
61#15	534.071	163.056
61#16	535.714	160.483
61#17	537.408	157.942
61#18	546.577	156.976
61#19	549.622	158.074
61#20	550.699	158.462
61#21	553.273	159.373
61#22	556.760	160.622
61#23	562.097	162.533
61#24	568.608	164.883
61#25	572.134	166.156
61#26	573.308	166.580
61#27	573.578	166.678
61#28	581.273	169.488
61#29	584.212	170.547

NO.	- X -	- Y -
61#30	595.535	3174.641
61#31	630.149	203.865
61#32	611.307	217.006
61#33	609.392	216.293
61#34	602.089	213.576
61#35	600.398	212.959
61#36	590.637	209.320
61#37	580.587	205.573
61#38	574.133	203.171
61#39	569.315	201.378
61#40	568.986	201.256

NO.	- X -	- Y -
61#57	545.037	3174.163
61#58	547.597	175.116
61#59	551.086	176.413
61#60	552.877	177.080
61#61	553.431	177.286
61#62	556.381	178.383
61#63	558.289	179.093
61#64	562.869	180.796
61#65	564.211	181.296
61#66	565.520	181.783

NO.	- X -	- Y -
61#67	566.049	3181.979
61#68	566.383	182.104
61#69	567.193	182.405
61#70	567.553	182.539
61#71	567.823	182.639
61#72	574.930	185.285
61#73	575.259	185.405
61#74	575.550	185.357
61#75	578.909	184.795
61#76	580.721	185.469
61#77	587.175	187.871
61#78	590.192	188.994
61#79	597.233	191.614
61#80	607.049	195.241
61#81	608.678	195.874
61#82	616.008	198.602
61#83	617.915	199.312
61#84	607.728	215.673
61#85	614.345	197.982

現地とは必ずしも一致しないことがあります。あくまで参考図としてご利用ください。
資料(写し)によって発生した直接または間接の損失、損害等については市では一切の責任を負いません。